IREDELL COUNTY HEALTH DEPARTMENT

STATESVILLE 704-878-5305 MOORESVILLE 704-664-5281

IMPROVEMENT PERMIT / AUTHORIZATION TO CONSTRUCT / OPERATION PERMIT / EXISTING SYSTEM INSPECTION

PERMIT# 111257 PIN# 4627590628 DATE 1-15-08

OWNER OR APPLICANT Mohammad Yaghi PHONE: Business 704-277-7697 Home

ADDRESS 4012 Wild Narsery Ct Charlotte NC 28205

LOCATION 150 West TH High Hills Drive SFE 29A on left Lot at end 167 High Hills Dr.

SUBDIVISION Pinnacle Shores BLOCK / SECTION LOT 29/29A LOT AREA .58 Ac +16525ft² SITE CLASS. PS SFE DESIGN FLOW 600gpd L.T.A.R. .3gpd/ft² (29A)

Septic Tank: 1500 Gallons: STB 353 Date 4/10/08

Pump Tank: 1500 Gallons: PT 352 Date 4/16/08

Pump Make: Blaster Model 33EB15225 Serial No 1.5hp

Nitrification Field: No Fields 1 Square Feet 1002 Linear Feet 334

No Lines 4@83' Trench Width 24"min. Max Trench Bottom Depth 36" Gravel Depth NA

☒ New System ☐ Repair ☐ Expansion System Type: I II III IV V VI

System Description: LPPPBPS

Repair System Description: LPPPBPS

Maintenance Agreement Required: ☒ Yes ☐ No

☒ House/Mod. Home ☐ Mobile Home ☐ Business ☐ Other

No. Bedrooms 5 No. Persons 10 No. Employees

Water Supply: ☐ Individual ☒ Public ☒ Community

☐ Gravity ☒ Pressure ☐ Slab ☒ Crawl Space ☒ Basement w/plumbing ☐ Basement wo/plumbing

Comments/Conditions: 36"max.


In-line pump tank filter required

77 panels


Comments/Conditions: 3/16" holes – 77 Panels

1" = 50'

INITIAL SITE SKETCH

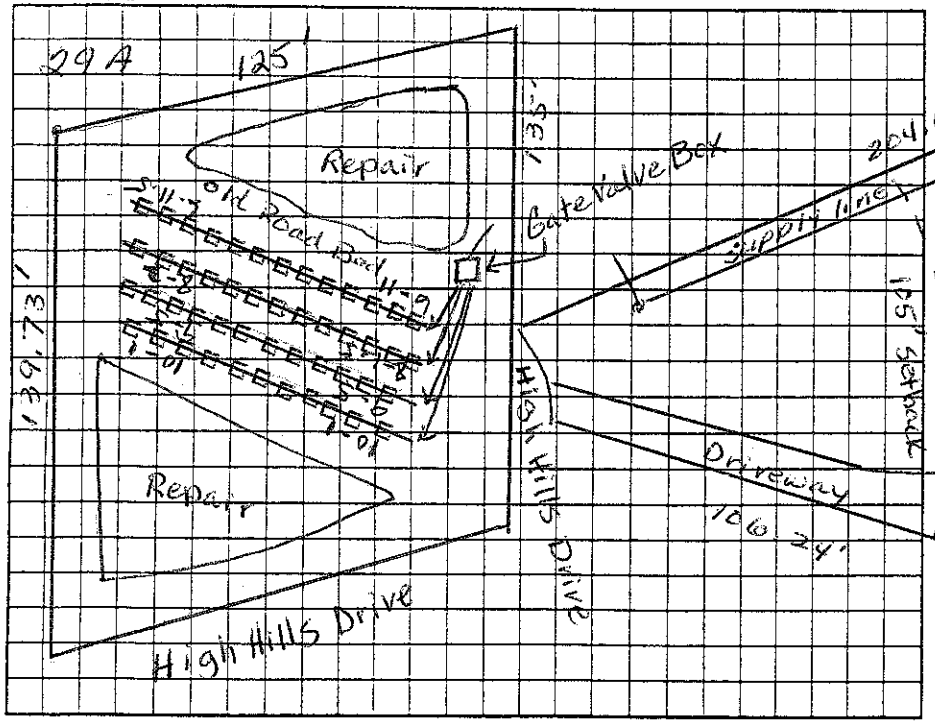

AS BUILT SKETCH

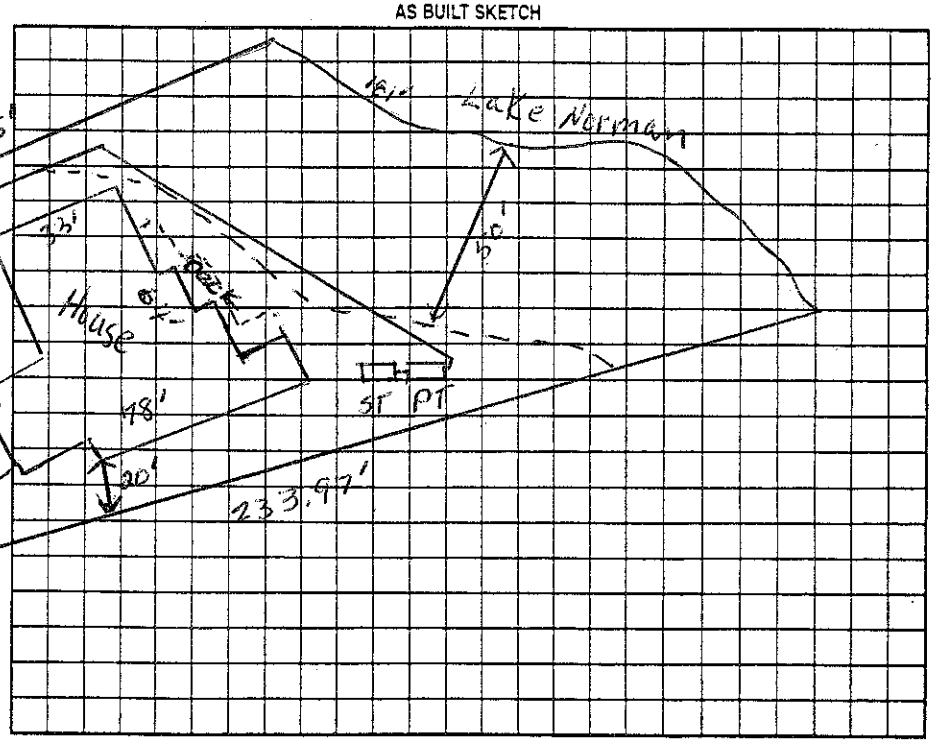

Permit can be suspended or revoked if any false information is supplied toward securing the permit/any unauthorized changes are made to the site/any unauthorized changes are made in the installation of the system. Improvement Permit with plat valid without expiration ☐ Improvement Permit with site plan valid for sixty months ☒ Authorization to Construct is valid for a period equal to that of Improvement Permit – not to exceed sixty months.

Signed: date 1-16-08 Installed by: Stanley Septic Tank

Improvement Permit by: Judy Melville date 1-15-08 Operation Permit by: date 7/8/08

Authorization to Construct by: Judy Melville date 1-16-08 Existing System Inspection by: date

HEALTH DEPT. COPY: WHITE OWNER COPY (FINAL): YELLOW OWNER COPY (INITIAL): PINK