IREDELL COUNTY HEALTH DEPARTMENT

STATESVILLE 704-878-5305 1550 Paid MOORESVILLE 704-664-5281

IMPROVEMENT PERMIT / AUTHORIZATION TO CONSTRUCT / OPERATION PERMIT / EXISTING SYSTEM INSPECTION

PERMIT# 111262 PIN# 4628-50-6657.31 4627-59-1931 DATE May 19, 03

OWNER OR CONTRACTOR Crescent Resources, Inc. / DON CARTER PHONE: Business _____ Home _____

ADDRESS P.O. Box 1003, Charlotte, N.C. 28201

LOCATION 150 West TL, High Hills DR. on left

SUBDIVISION Pinnacle Shores BLOCK / SECTION 4 LOT 31/31A LOT AREA 25048+44570 sf SITE CLASS. PSSFE DESIGN FLOW 460gpd L.T.A.R. .3

Septic Tank: 1000 Gallons; STB 1012 Date 2-8-06

Pump Tank: 1000 Gallons; PT 17 Date 5-8-06

Pump Make: _____ Model _____ Serial No. _____

Nitrification Field: No Fields 1 Square Feet 600/900 Linear Feet 300

No Lines 6@50' Trench Width 24" min 86c Max Trench Bottom Depth 36" Gravel Depth NA

☑ New System ☐ Repair System Type: I, II, (III), IV, V, VI

System Description: pm- PPBPS

Repair System Description: LP PPBPS

Maintenance Agreement Required: ☐ Yes ☑ No

☑ House/Mod. Home No. Bedrooms 4

☐ Mobile Home No. Bathrooms 3

☐ Business No. Employees ____

☐ Other _____


☐ Slab ☐ Crawl Space ☑ Basement w/plumbing ☐ Basement wo/plumbing

Water Supply: ☐ Individual ☑ Public ☑ Community

Comments:/Conditions: OF 36" MAX 96C

Comments:/Conditions:

INITIAL SITE SKETCH 1" = 100'

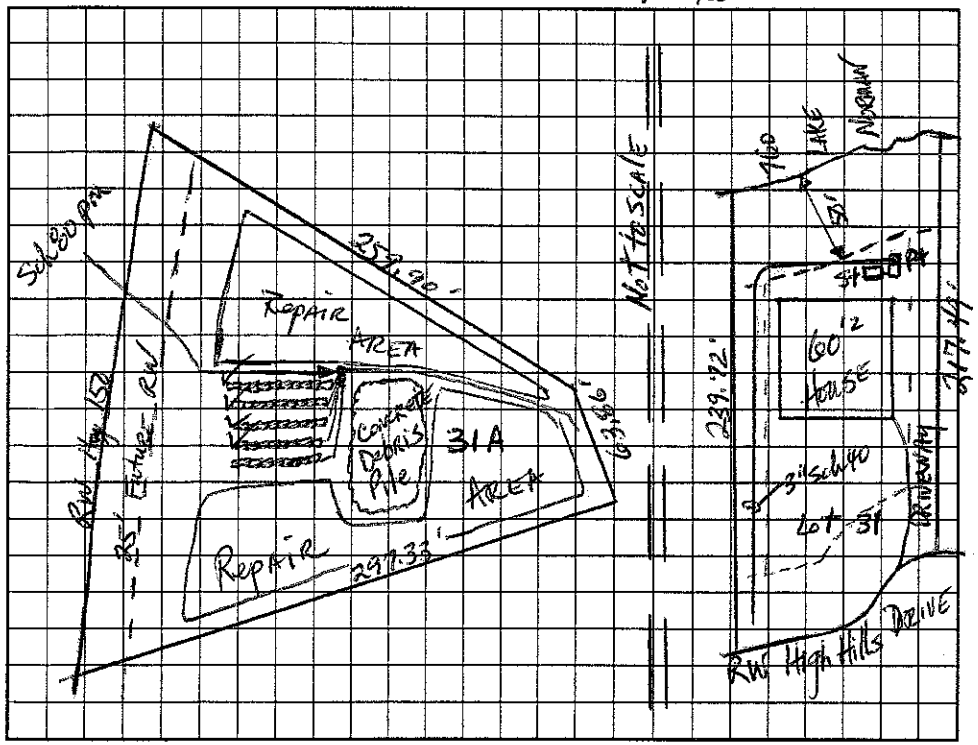

AS BUILT SKETCH

Permit can be suspended or revoked if any false information is supplied toward securing the permit/any unauthorized changes are made to the site/any unauthorized changes are made in the installation of the system. Improvement Permit with plat valid without expiration. Improvement Permit with site plan valid for sixty months. Authorization to Construct is valid for a period equal to that of Improvement Permit – not to exceed sixty months.

Signed: _____ date 5/20/03 Installed by: C+S

Improvement Permit by: _____ date 5-19-03 Operation Permit by: _____ date 9/11/06

Authorization to Construct by: _____ date 1/18/06 Existing System Inspection by: _____ date _____

HEALTH DEPT. COPY: WHITE OWNER COPY (FINAL): YELLOW OWNER COPY (INITIAL): PINK