IREDELL COUNTY HEALTH DEPARTMENT

STATESVILLE 704-878-5305 50.00 Paid MOORESVILLE 704-664-5281 23°

IMPROVEMENT PERMIT / AUTHORIZATION TO CONSTRUCT / OPERATION PERMIT / EXISTING SYSTEM INSPECTION

PERMIT# 108 757 PIN# 4627-60-1578 DATE

OWNER OR CONTRACTOR [redacted] Heritage Homes PHONE: Business 704 309 5452 Home

ADDRESS PO Box 3333 Mooresville NC 28117

LOCATION BSR, TR McKendree, TR Grasshopper bear Lt, on Lt on corner w/ Passage Ct

SUBDIVISION CLIFT BLOCK / SECTION 8 LOT 432 LOT AREA 0.70Ac SITE CLASS. PS DESIGN FLOW 360 L.T.A.R. 0.3

Septic Tank: 1000 Gallons; STB 350 Date

Pump Tank: 1000 Gallons; PT 318 Date

Pump Make: Model Serial No.

Nitrification Field: No Fields 1 Square Feet 600 Linear Feet 200'

No Lines 4@50' Trench Width 24"or36" Max Trench Bottom Depth 36" Gravel Depth —

☒ New System ☐ Repair System Type: I, II, (III), IV, V, VI

System Description: PM Panel Block

Repair System Description: Limited-.1945c

Maintenance Agreement Required: ☐ Yes ☒ No

☒ House/Mod. Home No. Bedrooms 3

☐ Mobile Home No. Bathrooms

☐ Business No. Employees

☐ Other

☐ Slab ☐ Crawl Space ☒ Basement w/plumbing ☐ Basement wo/plumbing


Water Supply: ☒ Individual ☐ Public ☐ Community

Comments:/Conditions: Must properly Abandon old well


1"=50'

Comments:/Conditions:

INITIAL SITE SKETCH

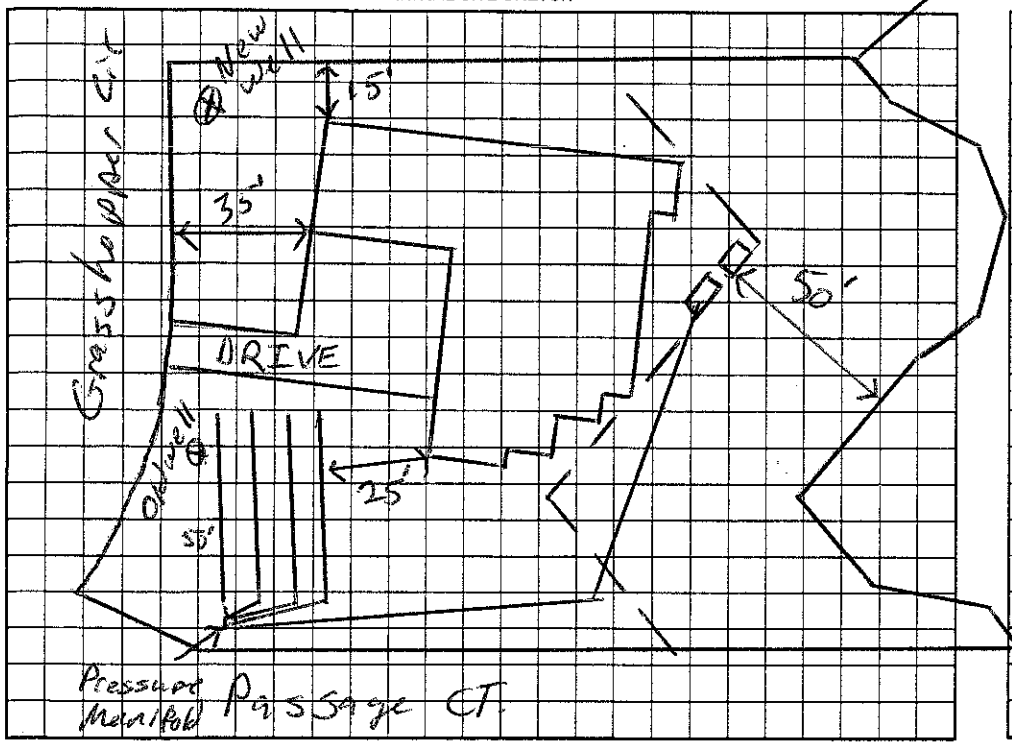

AS BUILT SKETCH

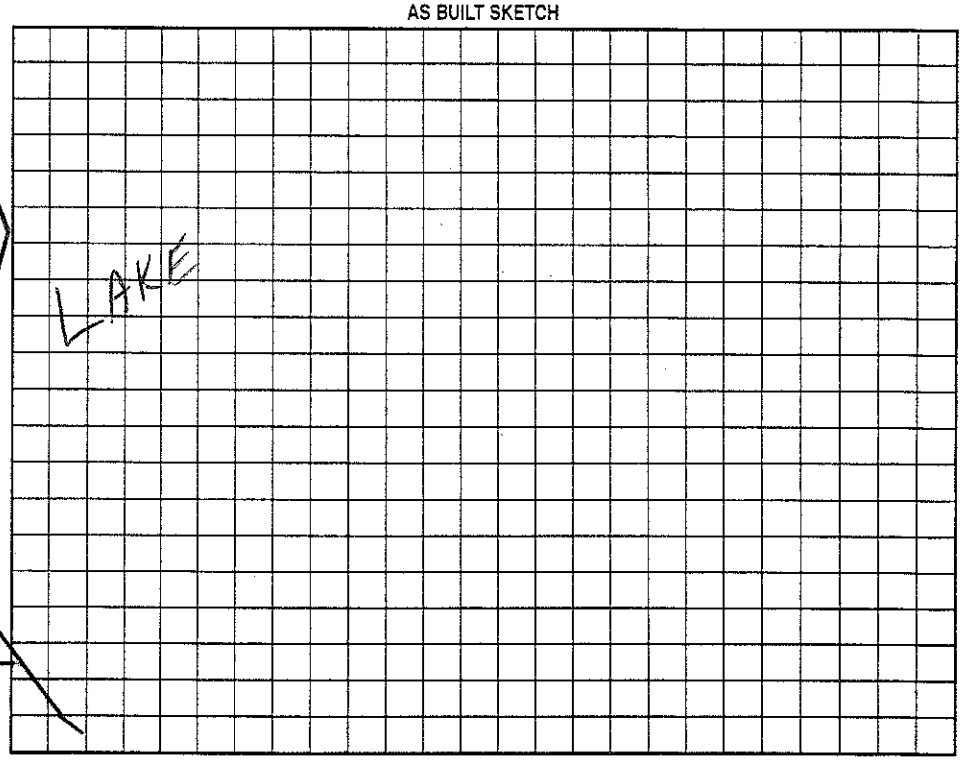

Permit can be suspended or revoked if any false information is supplied toward securing the permit/any unauthorized changes are made to the site/any unauthorized changes are made in the installation of the system. Improvement Permit with plat valid without expiration. Improvement Permit with site plan valid for sixty months. Authorization to Construct is valid for a period equal to that of Improvement Permit – not to exceed sixty months.

Signed: WM Falke date 6-6-05 Installed by: Piedmont Septic

Improvement Permit by: RS date 6/13/05 Operation Permit by: RS date 8/25/06

Authorization to Construct by: RS date 6/13/05 Existing System Inspection by: date

HEALTH DEPT. COPY: WHITE OWNER COPY (FINAL): YELLOW OWNER COPY (INITIAL): PINK