IREDELL COUNTY HEALTH DEPARTMENT

Statesville Phone TR 3-7271 Mooresville Phone NO 3-1271

PERMIT TO INSTALL SEPTIC TANK

1st permit

Permit No. _____ Permit Date 26 Aug 1965

Owner C. L. Rutledge Address 631 N. Oak Ave

Installed By Hoke Address Statesville (Civil), N. C.

Location of Property Lake Norman Sect 8 Lot 432


255 Grasshopper

Tank		Capacity		Length of Lines		Fixtures	
Block	(✓)	1000	(✓)	225'	(✓)	No. of Baths	( )
Precast	( )	1250	( )	250'	( )	Dishwasher	( )
		1500	( )	Other _____		Garbage Grdr.	( )
		Other _____				Other _____	

NOTIFY HEALTH DEPARTMENT AT LEAST EIGHT HOURS BEFORE TANK IS TO BE INSPECTED.

Final Inspection 26 Aug 1965 Approved (✓) Disapproved ( )

Remarks _____

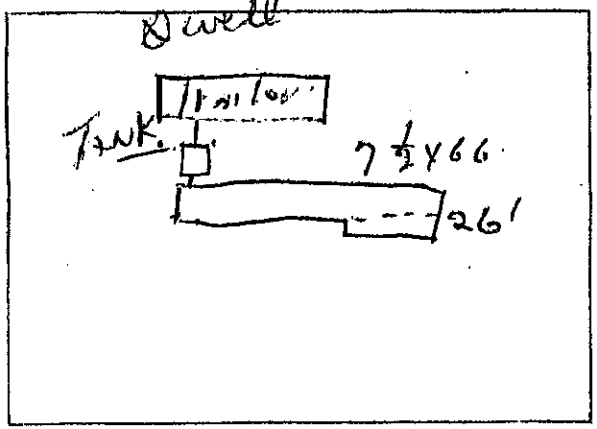

Sketch of Installation

Troy Scoggins RO

Sanitarian