IREDELL COUNTY HEALTH DEPARTMENT

Authorization to Construct — 2nd

STATESVILLE 704-878-5305 MOORESVILLE 704-664-5281

IMPROVEMENT PERMIT / ~~CERTIFICATE OF COMPLETION~~ / OPERATION PERMIT / EXISTING SYSTEM INSPECTION

PROPERTY DESCRIPTION NO. 26147 DATE 2/28/97 TAX MAP NO. 4627602822 Watershed: ☒ Yes ☐ No

OWNER OR CONTRACTOR Glen Robinson PHONE: Business _____ Home 364-6475

ADDRESS 134 Cobalt Way Charlotte, NC. 28211

LOCATION 1100 TR McKendree TR Grasshopper Circle (L) fork to 8th mailbox on (L)

SUBDIVISION CL+T BLOCK / SECTION 8 LOT 436 LOT AREA ~1AC SITE CLASS. PS DESIGN FLOW 360 L.T.A.R. .3

Septic Tank: 1000 Gallons; STB 794 Date 3/11/97

Pump Tank: _____ Gallons; PT _____ Date _____

Pump Make: _____ Model _____ Serial No. _____

Nitrification Field: No Fields 3 Square Feet 900 ✱ Linear Feet 300 ✱

No Lines 3 Trench Width 36" Max Trench Bottom Depth 30" Gravel Depth SAND.

☒ New System ☐ Repair System Type: I, II, ☒ III, IV, V, VI

System Description: GRAV-CH PLASTIC

Repair System Description: Pass Panel.

Maintenance Agreement Required: ☐ Yes ☒ No

☒ House/Mod. Home No. Bedrooms 3

☐ Mobile Home No. Bathrooms 3

☐ Business No. Employees _____

☐ Other _____


☐ Slab ☒ Crawl Space ☐ Basement w/plumbing ☐ Basement wo/plumbing

Water Supply: ☒ Individual ☐ Community ☐ Public

Comments:

Comments:

INITIAL SITE SKETCH

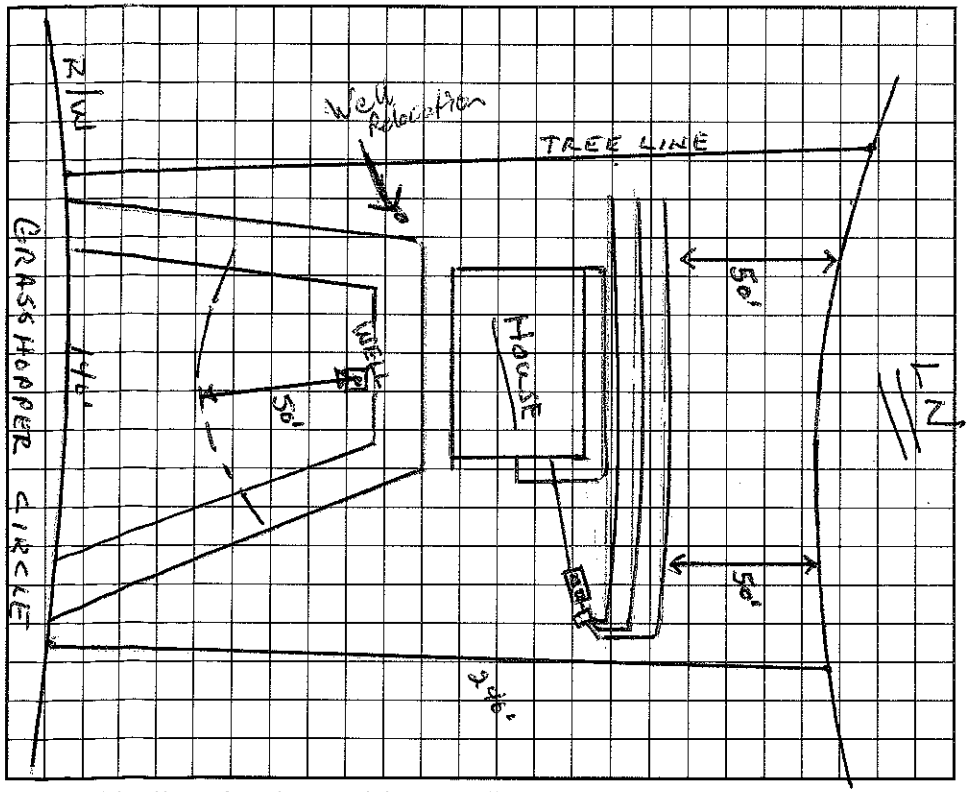

AS BUILT SKETCH

SAME AS SKETCH

I understand that this permit can be suspended or revoked if any false information is supplied toward securing the permit/any unauthorized changes are made to the site/any unauthorized changes are made in the installation of the system. Improvement Permit is valid for 60 months from date of issuance.

Signed: ✱

Improvement Permit by: Wesley Sparks R.S. date 2/28/97

~~Existing System Inspection by:~~ Wesley Sparks R.S. date 2/28/97

Installed by: EJ ERVIN

Certificate of Completion by: _____ date _____

Operation Permit by: [signature] date 10/10/97

HEALTH DEPT. COPY: WHITE INSPECTION COPY (FINAL): GREEN OWNER COPY (FINAL): YELLOW INSPECTION COPY (INITIAL): PINK OWNER COPY (INITIAL): GOLD