IREDELL COUNTY HEALTH DEPARTMENT

Statesville Office (704) 878-5305 | Mooresville Office (704) 660-3625 | PERMIT # 216162

BA

IMPROVEMENT PERMIT / AUTHORIZATION TO CONSTRUCT / OPERATION PERMIT / EXISTING SYSTEM

PIN # 4627-60-4276.000

APPLICANT: LaVanne Thrasher | APPLICANT ADDRESS: 242 Grasshopper Cir. Mooresville NC

SITE ADDRESS: 242 Grasshopper Cir. Mooresville NC 28117 | PHONE: 704-682-8966 | ALT. PHONE:

SITE DIRECTIONS: BSR TR McKendree, TR Grasshopper, @ Y STAY LEFT, SITE ON R

SUBDIVISION: The Farms | SECTION: 5 | LOT # 600 | LOT AREA: .891 Acre | DESIGN FLOW: Ex. 600 GPD | L.T.A.R.: Existing


Septic Tank: Existing (gal) | STB | Date
Pump Tank: Existing (gal) | PT | Date
Pump Make: Ex | Model | Serial #
Nitrification Fields: Ex | # Lines: Ex | Linear Ft: Ex
Trench Width: Ex | Max. Trench Bottom Depth: Ex | Gravel Depth: Ex

☐ New System ☐ Repair ☐ Expansion System Type: I II III IV V VI
System Description: Existing LP-PRSPS
Repair System Description: LP-PRSPS
Maintenance Agreement Required: ☒ YES ☐ NO
☐ GRAVITY ☒ PRESSURE


☒ Residence | No. Bedrooms: Ex 5 | Water Supply: ☐ Private
☐ Business | No. Persons: Ex 10 | ☐ Public
☐ Other | No. Employees: | ☒ Community
☐ Slab | ☒ Crawl Space
☐ Basement w/plumbing | ☐ Basement w/o plumbing

Comments / Conditions: Existing System Appeared To Be Functioning @ Time of Inspection.
Maintain 5' Separation From Existing Septic System w/ Proposed Garage.

INITIAL SITE SKETCH

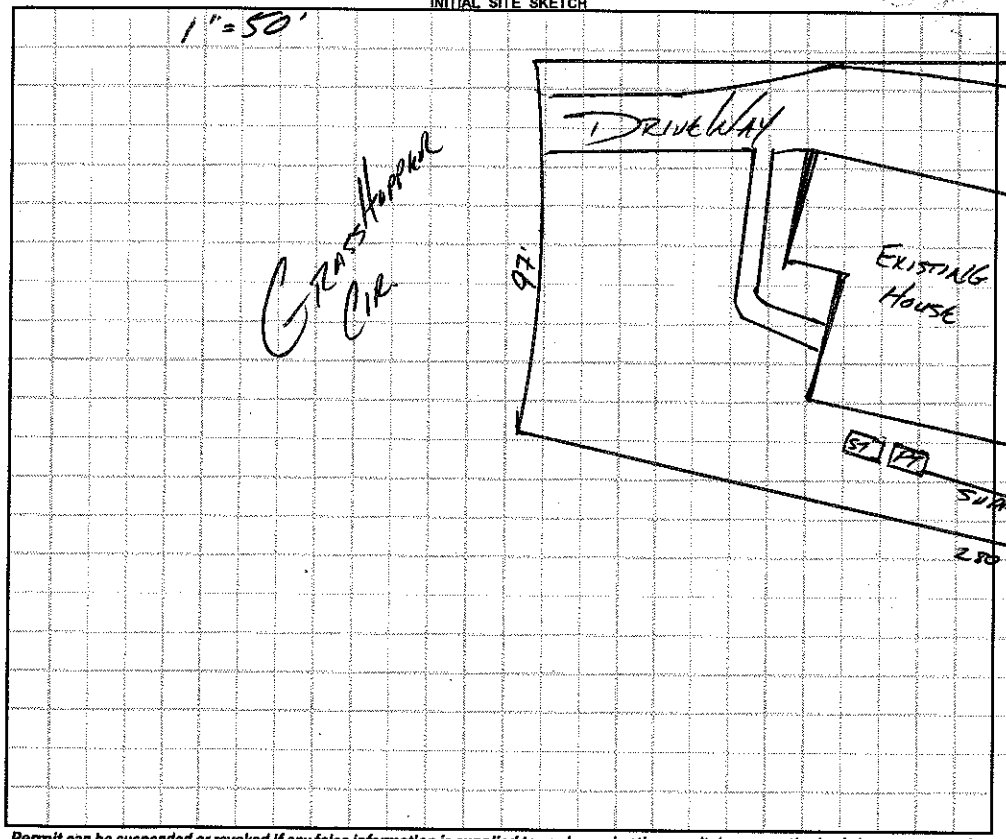

AS BUILT SKETCH

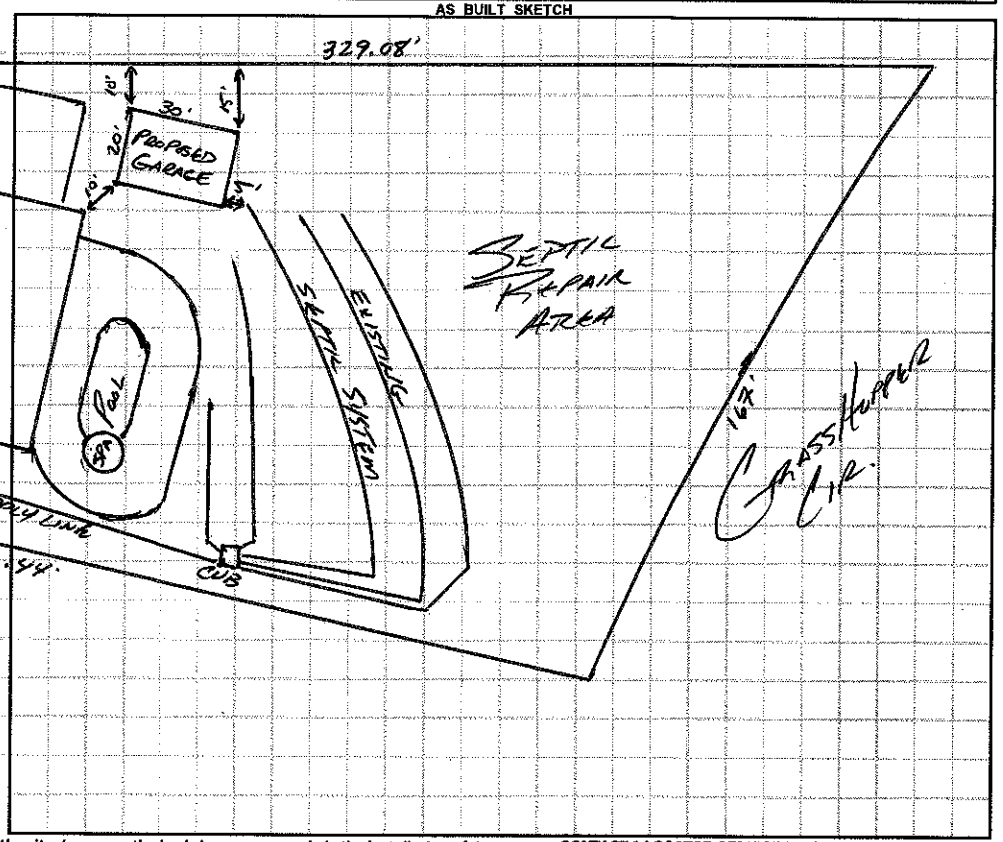

Permit can be suspended or revoked if any false information is supplied toward securing the permit / any unauthorized changes are made to the site / any unauthorized changes are made in the installation of the system. **CONTACT A LOCATOR SERVICE PRIOR TO ANY EXCAVATION**

☐ **IMPROVEMENT PERMIT *with plat*** *valid without expiration.* ☐ **IMPROVEMENT PERMIT *with site plan*** *valid for 60 mos.* ☐ **AUTHORIZATION TO CONSTRUCT** *valid for period equal to IMPROVEMENT PERMIT--not to exceed 60 mo.*

Owner / Applicant Signature: Wayne Thrasher | Date: 2/24/16 | Installed by:

IMPROVEMENT PERMIT by: | Date: | OPERATION PERMIT by: | Date:

AUTHORIZATION TO CONSTRUCT by: | Date: | Existing System Inspected by:

APPROVED FEB 24 2016

Health Dept. Copy - WHITE Applicant (Final Approval) - YELLOW Applicant (Conditional Approval) - PINK