4627 60 7285

IREDELL COUNTY HEALTH DEPARTMENT

STATESVILLE 704-878-5305 MOORESVILLE 704-664-5281

IMPROVEMENT PERMIT / CERTIFICATE OF COMPLETION / OPERATION PERMIT / EXISTING SYSTEM INSPECTION

PROPERTY DESCRIPTION NO. 16237 DATE APRIL 26, 1993 TAX MAP NO. 2L-2A-458

OWNER OR CONTRACTOR CHARLES V. BROOKS, JR PHONE: Business Home 788-6511

ADDRESS 144 EAST CLIFF DRIVE, CONCORD, N.C.

LOCATION 1100 TR 1115 TR 1215 (grasshopper) bear right at forks ~1/2 mile on right 409 Grasshopper

SUBDIVISION CRESCENT/Lake Norman BLOCK / SECTION 8 LOT 458 LOT AREA existing SITE CLASS. P L.T.A.R. 0.3

Water Supply: ☒ Individual ☐ Community ☐ Public

Septic Tank: EXISTING Gallons; STB Date

Pump Tank: Gallons; PT Date

Nitrification Field: No Fields 1 Square Feet 750 Linear Feet 250

No Lines 3 Trench Width 36" Trench Depth 30" Gravel Depth 12"

☐ New System ☒ Repair System Type: I, II, III, IV, V, VI

System Description:

Repair System Description: gravity conventional

Maintenance Agreement Required: ☐ Yes ☒ No

☐ House/Mod. Home ☒ Mobile Home ☐ Business ☐ Other

No. Bedrooms 3 No. Bathrooms 2 No. Employees

☒ Slab ☐ Crawl Space ☐ Basement w/plumbing ☐ Basement wo/plumbing

Garbage Disposal: ☐ Yes ☒ No

Auto. Dishwasher: ☒ Yes ☐ No


Auto. Washing Machine: ☒ Yes ☐ No

Other

Comments Single wide MH unblocked + ready to move, 2x MH being prepared for set up.

INITIAL SITE SKETCH

AS BUILT SKETCH

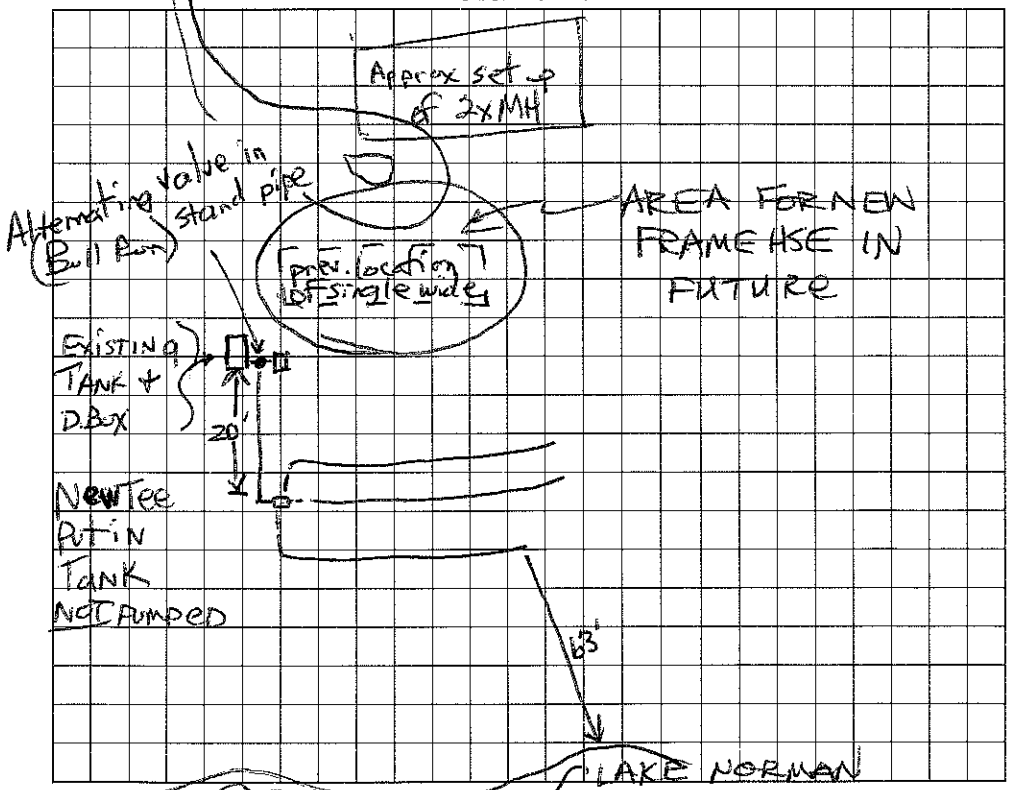

I understand that this permit can be suspended or revoked if any false information is supplied toward securing the permit/any unauthorized changes are made to the site/any unauthorized changes are made in the installation of the system. Improvement Permit is valid for 60 months from date of issuance.

Signed:

Improvement Permit by: Andrea Lemon date Aug 3, 1993

Existing System Inspection by: date

Installed by:

Certificate of Completion by: date

Operation Permit by: Bridg Fenner / by Andrea Lemon date 11/7/94

HEALTH DEPT. COPY: WHITE INSPECTION COPY (FINAL): GREEN OWNER COPY (FINAL): YELLOW INSPECTION COPY (INITIAL): PINK OWNER COPY (INITIAL): GOLD

4627 60 7285

IREDELL COUNTY HEALTH DEPARTMENT

STATESVILLE 704-878-5305 MOORESVILLE 704-664-5281

IMPROVEMENT PERMIT / CERTIFICATE OF COMPLETION / OPERATION PERMIT / EXISTING SYSTEM INSPECTION

PROPERTY DESCRIPTION NO. 220-32 45304 Existing System DATE 3/22/96 TAX MAP NO. 2L-2-A-458 Watershed: ☑ Yes ☐ No

OWNER OR CONTRACTOR Charles Brooks PHONE: Business Home 664-9397

ADDRESS 469 Grasshopper Cl Mooresville NC 28115

LOCATION Ukenbrec Rd - TR Grasshopper Cl. - ~~Bucket~~ Go Left at Y in Rd - 404# on box

SUBDIVISION C L & T BLOCK / SECTION 8 LOT 453 LOT AREA 1 ac SITE CLASS PS DESIGN FLOW 300 L.T.A.R. .35 gpd/ft

Septic Tank: 1000 Gallons; STB Date

Pump Tank: Gallons; PT Date

Pump Make: Model Serial No.

Nitrification Field: No Fields 1 Square Feet 900 Linear Feet 300

No Lines 3 Trench Width 36" Max Trench Bottom Depth 36" Gravel Depth 12"

☑ New System ☐ Repair System Type: I. II. (III.) IV. V. VI

System Description: Existing

Repair System Description: Existing

Maintenance Agreement Required: ☐ Yes ☑ No

☐ Slab ☑ Crawl Space ☐ Basement w/plumbing ☐ Basement wo/plumbing

☑ House/Mod. Home No. Bedrooms 3

☐ Mobile Home No. Bathrooms 2

☐ Business No. Employees


☐ Other

Water Supply: ☑ Individual ☐ Community ☐ Public


Comments:

Comments: Tie into ~~old~~ old System.

INITIAL SITE SKETCH

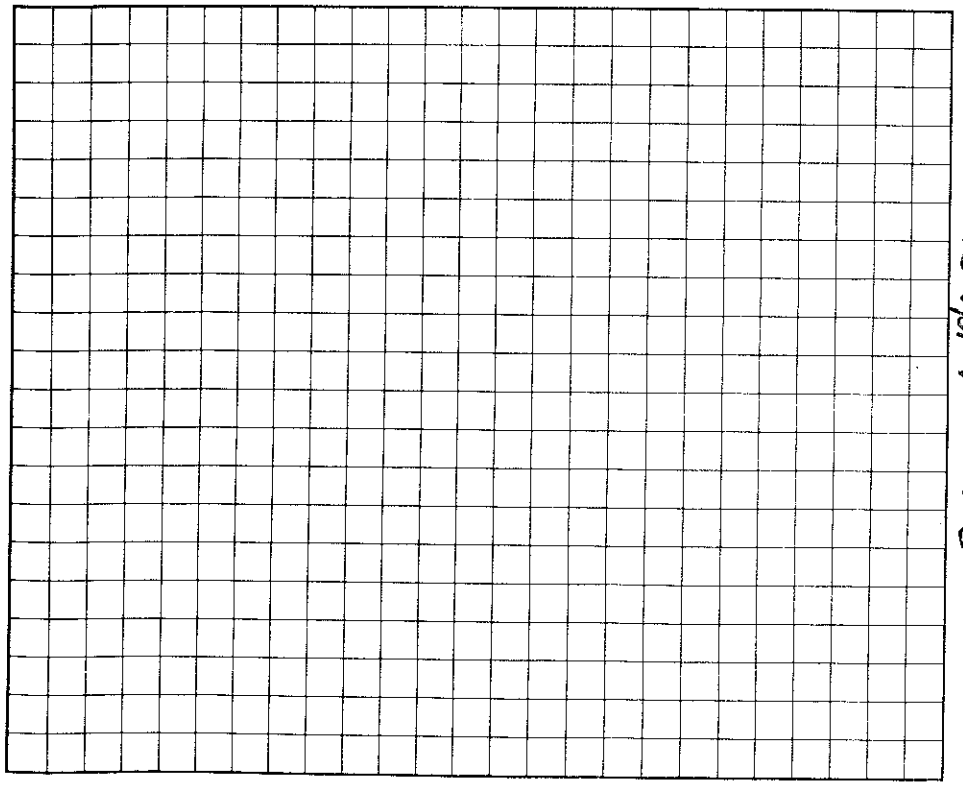

AS BUILT SKETCH

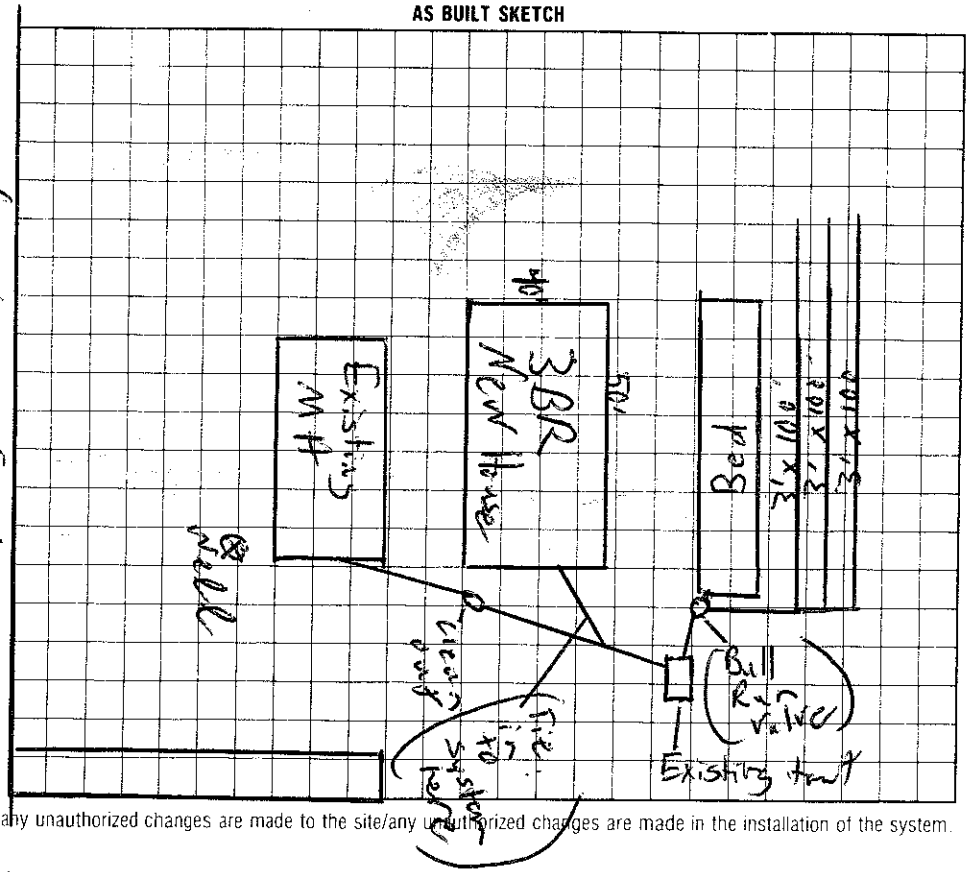

I understand that this permit can be suspended or revoked if any false information is supplied toward securing the permit/any unauthorized changes are made to the site/any unauthorized changes are made in the installation of the system.

Signed:

Improvement Permit by: date

Existing System Inspection by: C. Beaty Thomas EHSI date 3/22/96

Installed by:

Certificate of Completion by: C date

Operation Permit by: date

HEALTH DEPT. COPY: WHITE INSPECTION COPY (FINAL): GREEN OWNER COPY (FINAL): YELLOW INSPECTION COPY (INITIAL): PINK OWNER COPY (INITIAL): GOLD