IREDELL COUNTY HEALTH DEPARTMENT

Statesville Office (704) 878-5305 Mooresville Office (704) 660-3625 PERMIT # 213866

IMPROVEMENT PERMIT / AUTHORIZATION TO CONSTRUCT / OPERATION PERMIT / EXISTING SYSTEM

PIN # 4627-60-7285

APPLICANT: Rollins Soil & Environmental APPLICANT ADDRESS: PO Box 832 Mooresville NC

SITE ADDRESS: 409 Grasshopper Cir., Mrsvl. PHONE: ALT. PHONE:

SITE DIRECTIONS: Brawley Sch Rd, TR on McKendree, TR on Grasshopper, Keep R, Lot to R

SUBDIVISION: CL&T SECTION: 8 LOT # 458 LOT AREA: 0.76 ac DESIGN FLOW: 480 gpd L.T.A.R.: 0.275

Septic Tank	Existing	(gal)	STB	Existing	Date	Existing	☐ New System	☐ Repair	☑ Expansion	System Type: I II (III) IV V VI	☑ Residence	No. Bedrooms	4	Water Supply	
Pump Tank	—	(gal)	PT	—	Date	—	System Description:	Existing Gravel lines + Gravity PPBPS			☐ Business	No. Persons	8	☑ Private	
Pump Make	—	Model	—		Serial #	—	Repair System Description:	LP PPBPS w/ TS-II Pretreat.			☐ Other	No. Employees		☐ Public	
# Nitrification Fields	1	# Lines	2 (1CF)	Linear Ft:	73'		Maintenance Agreement Required:	☐ YES	☑ NO		☐ Slab	☐ Crawl Space		☐ Community	
Trench Width	24"	Max. Trench Bottom Depth	30"	Gravel Depth	N/A		☑ GRAVITY	☐ PRESSURE			☑ Basement w/plumbing			☐ Basement w/o plumbing	

Comments / Conditions: Trench bottom per design specs. Well in front yard must be abandoned prior to issuing AC. *Remove existing patio from uppermost existing grave line. Well must be abandoned prior to issuing AC.


INITIAL SITE SKETCH

Patio Removed, well abandoned see attached 6w30 ALP

SEE DESIGN BY ROLLINS SOIL & Environmental Services

(Approved 10-29-15 ALP)

AS BUILT SKETCH

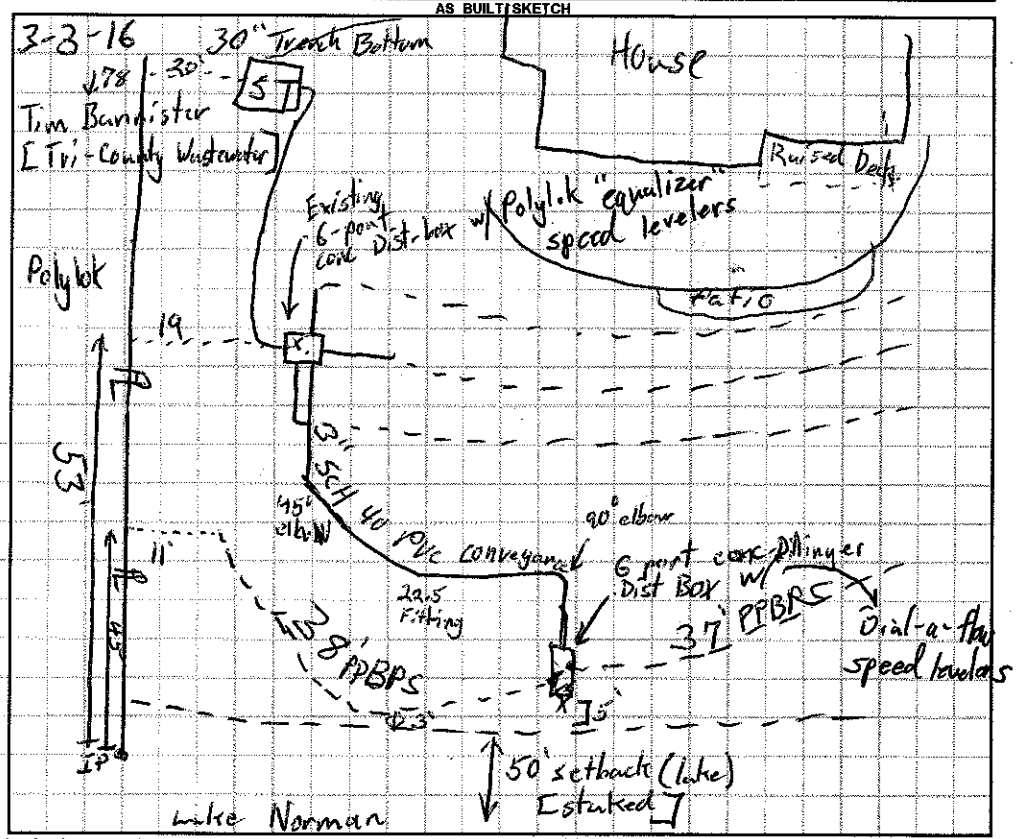

Permit can be suspended or revoked if any false information is supplied toward securing the permit / any unauthorized changes are made to the site / any unauthorized changes are made in the installation of the system. **CONTACT A LOCATOR SERVICE PRIOR TO ANY EXCAVATION**

☐ **IMPROVEMENT PERMIT** *with plat valid without expiration.* ☑ **IMPROVEMENT PERMIT** *with site plan valid for 60 mos.* ☒ **AUTHORIZATION TO CONSTRUCT** *valid for period equal to IMPROVEMENT PERMIT--not to exceed 60 mo.*

Owner / Applicant Signature: Date: 11-3-15 Installed by: C Wayne Orbison

IMPROVEMENT PERMIT by: Date: 10-29-15 OPERATION PERMIT by: Tom Shuck Date: 3-3-16

AUTHORIZATION TO CONSTRUCT by: Date: 2-9-16 Existing System Inspected by: Date:

Health Dept. Copy - WHITE Applicant (Final Approval) - YELLOW Applicant (Conditional Approval) - PINK

APPROVED OCT 2 9 2015

