IREDELL COUNTY HEALTH DEPARTMENT

STATESVILLE 704-878-5305 MOORESVILLE 704-664-5281

IMPROVEMENT PERMIT / AUTHORIZATION TO CONSTRUCT / OPERATION PERMIT / EXISTING SYSTEM INSPECTION

PERMIT # 15787 PIN # 4627607285 DATE 8-14-2009

OWNER or APPLICANT Joseph Polak PHONE: Business 704 516 5593 Home: 704 360-4330

OWNER or APPLICANT ADDRESS 409 Grasshopper Circle Mooresville, NC 28117

LOCATION / DIRECTIONS Brawley School

SUBDIVISION C & T BLOCK / SECTION 8 LOT # 458 LOT AREA DESIGN FLOW 360 gpd L.T.A.R.

Septic Tank Exist 1000 Gallons: STB Date

Pump Tank Gallons: P.T Date

Pump Make Model Serial #

Nitrification Field No Fields No Lines Linear Feet Existing

Trench Width Max. Trench Bottom Depth Gravel Depth

☐ New System ☐ Repair ☐ Expansion System Type I II III IV V VI

System Description: Exist. Conv.

Repair System Description:

Maintenance Agreement Required ☐ YES ☒ NO

☒ GRAVITY ☐ PRESSURE

☒ Residence No. Bedrooms 3-4

☐ Business No. Persons

☐ Other No. Employees

☐ Slab ☐ Crawl Space


☐ Basement w/plumbing ☐ Basement w/o plumbing

Water Supply: ☒ Private ☐ Public ☐ Community

Comments / Conditions: Existing Septic System appears to be functioning okay at time of inspection.

Comments / Conditions: Addition of Basement, formerly a Crawl space. Should not impact Septic System. Permit referenced was Existing permit 3/22/94

INITIAL SITE SKETCH

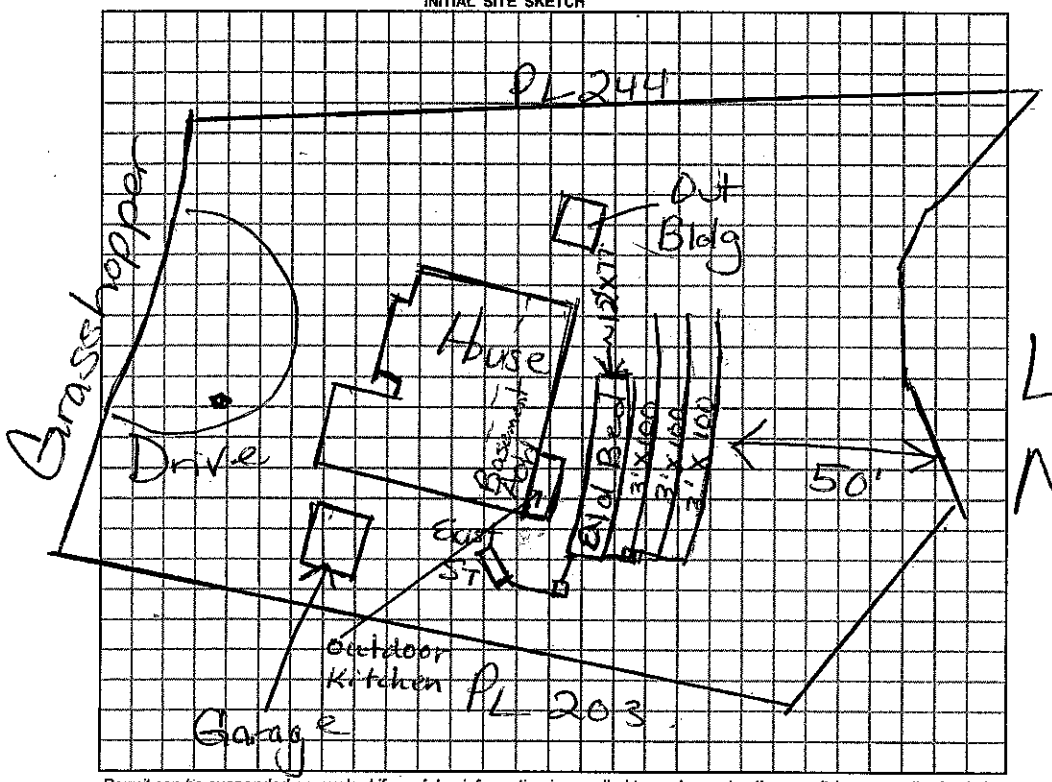

AS BUILT SKETCH

Could not find original permit
* Note: If Old Bed ~ 17ft x 13ft is used, Site may be approved for 4 Bedrooms.

The location of the proposed Outdoor Kitchen addition does not appear to impact the existing septic system.

**NOTE: Shall be min. 5' from septic system

Cindy Melville REHS

Date: 11-01-12

ICHD-Environmental Health Division

Permit can be suspended or revoked if any false information is supplied toward securing the permit / any unauthorized changes are made to the site / any unauthorized changes are made in the installation of the system.

☐ *IMPROVEMENT PERMIT w / plat valid without expiration.* ☐ *IMPROVEMENT PERMIT w / site plan valid for 60 mos.* ☐ *AUTHORIZATION TO CONSTRUCT valid for period equal to IMPROVEMENT PERMIT-not to exceed 60 mo.*

Owner / Applicant Signature: Date 8/21/09

Improvement Permit by: Maria H. Dotson RS Date 8/17/09

Authorization to Construct by: Maria H. Dotson RS Date 8/17/09

YOU SHOULD CONTACT A LOCATOR SERVICE PRIOR TO ANY EXCAVATION!

Installed by:

Operation Permit by: Date:

Existing System Inspected by: Maria H. Dotson RS Date: 8/17/09

WHITE COPY Environmental Health YELLOW COPY (Final) Owner / Applicant PINK COPY (Initial) Owner / Applicant