IREDELL COUNTY HEALTH DEPARTMENT

STATESVILLE 704-878-5305 MOORESVILLE 704-664-5281

IMPROVEMENT PERMIT / CERTIFICATE OF COMPLETION / OPERATION PERMIT / EXISTING SYSTEM INSPECTION

PROPERTY DESCRIPTION NO. 48304 Existing Sys DATE 3/22/96 TAX MAP NO. 2L-2-A-458 Watershed: ☒ Yes ☐ No

OWNER OR CONTRACTOR Charles Brooks PHONE: Business Home 664-9397

ADDRESS 469 Grasshopper Cl Mooresville NC 28115

LOCATION Ukeorbrey Rd - TR Grasshopper Cl. - Go Left at Y in Rd - 409# on box

SUBDIVISION Clay BLOCK / SECTION 8 LOT 453 LOT AREA 1 ac SITE CLASS. PS DESIGN FLOW 300 L.T.A.R. .35 gpd/ft²

Septic Tank: 1000 Gallons; STB Date

Pump Tank: Gallons; PT Date

Pump Make: Model Serial No.

Nitrification Field: No Fields 1 Square Feet 900 Linear Feet 300

No Lines 3 Trench Width 36" Max Trench Bottom Depth 36" Gravel Depth 12"

☒ New System ☐ Repair System Type: I. II. III. IV. V. VI

System Description: Existing

Repair System Description: Existing

Maintenance Agreement Required: ☐ Yes ☒ No

☒ House/Mod. Home No. Bedrooms 3

☐ Mobile Home No. Bathrooms 2

☐ Business No. Employees

☐ Other


☐ Slab ☒ Crawl Space ☐ Basement w/plumbing ☐ Basement wo/plumbing

Water Supply: ☒ Individual ☐ Community ☐ Public


Comments:

Comments: Tie into old System.

INITIAL SITE SKETCH

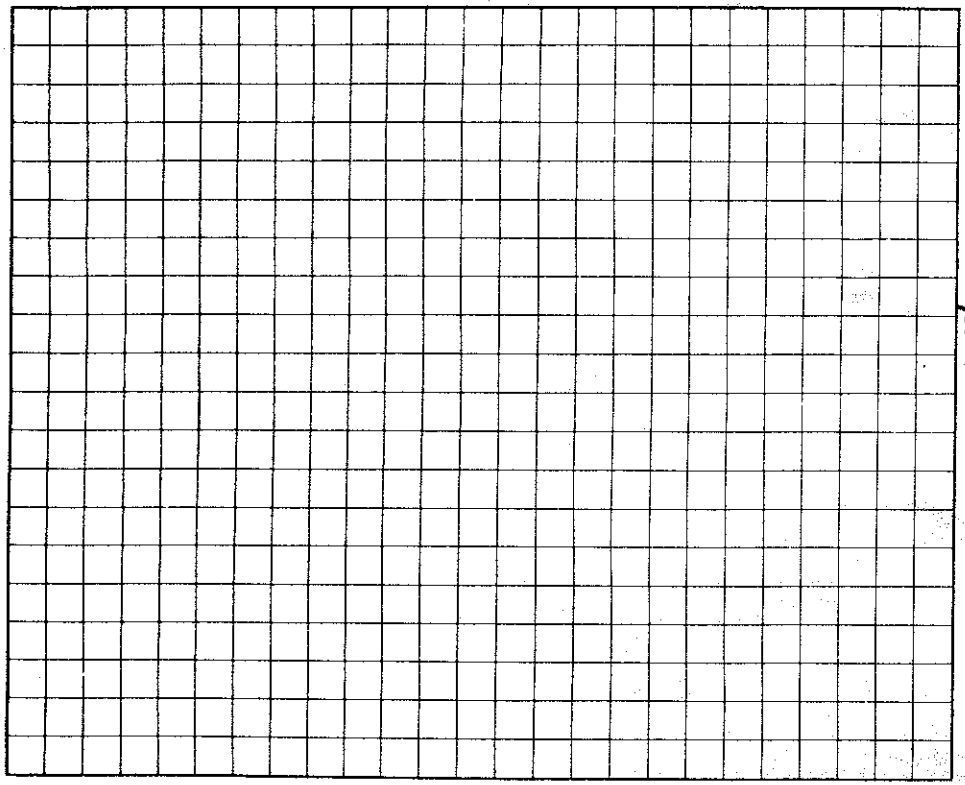

AS BUILT SKETCH

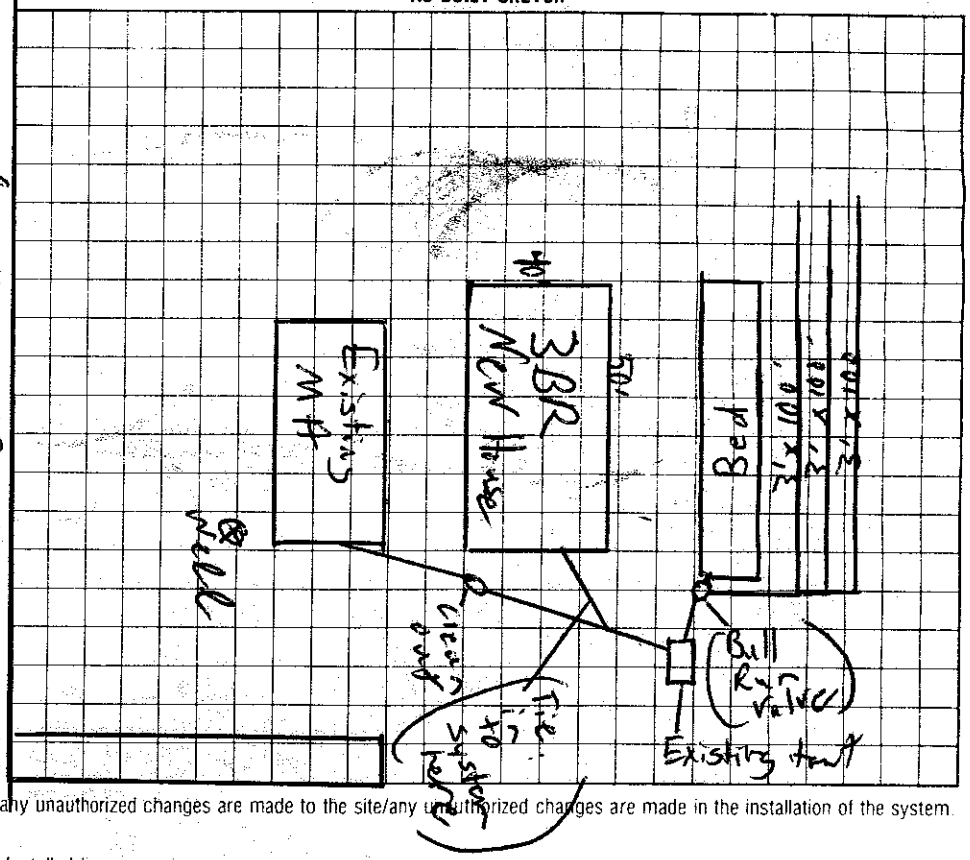

I understand that this permit can be suspended or revoked if any false information is supplied toward securing the permit/any unauthorized changes are made to the site/any unauthorized changes are made in the installation of the system.

Signed:

Improvement Permit by: date

Existing System Inspection by: C. Bob Isaacs EHS date 3/22/96

Installed by:

Certificate of Completion by: C date

Operation Permit by: date

HEALTH DEPT. COPY: WHITE INSPECTION COPY (FINAL): GREEN OWNER COPY (FINAL): YELLOW INSPECTION COPY (INITIAL): PINK OWNER COPY (INITIAL): GOLD