IREDELL COUNTY HEALTH DEPARTMENT

STATESVILLE 704-878-5305 MOORESVILLE 704-664-5281

IMPROVEMENT PERMIT / CERTIFICATE OF COMPLETION / OPERATION PERMIT / EXISTING SYSTEM INSPECTION

PROPERTY DESCRIPTION NO. ~~22632~~ ~~48304~~ Existing System DATE 3/22/96 TAX MAP NO. 2L-2-A-458 Watershed: ☑ Yes ☐ No

OWNER OR CONTRACTOR Charles Brooks PHONE: Business Home 664-9397

ADDRESS 409 Grasshopper Cl Mooresville NC 28115

LOCATION Wakentree Rd - TR Grasshopper Cl. - [redacted] Go left at Y in Rd - 409# on box

SUBDIVISION CLOT BLOCK / SECTION 8 LOT 458 LOT AREA 2 lac SITE CLASS. PS DESIGN FLOW 360 L.T.A.R. .35 gpd/ft

Septic Tank: 1000 Gallons: STB Date

Pump Tank: Gallons: PT Date

Pump Make: Model Serial No.

Nitrification Field: No Fields 1 Square Feet 900 Linear Feet 300

No Lines 3 Trench Width 36" Max Trench Bottom Depth 36" Gravel Depth 12"

☑ New System ☐ Repair System Type: I. II. III. IV. V. VI

System Description: Existing

Repair System Description: Existing

Maintenance Agreement Required: ☐ Yes ☑ No

☑ House/Mod. Home No. Bedrooms 3

☐ Mobile Home No. Bathrooms 2

☐ Business No. Employees

☐ Other

Slab ☑ Crawl Space ☐ Basement w/plumbing ☐ Basement wo/plumbing


Water Supply: ☑ Individual ☐ Community ☐ Public

Comments:

Comments: Tie into [redacted] old System.

INITIAL SITE SKETCH

AS BUILT SKETCH

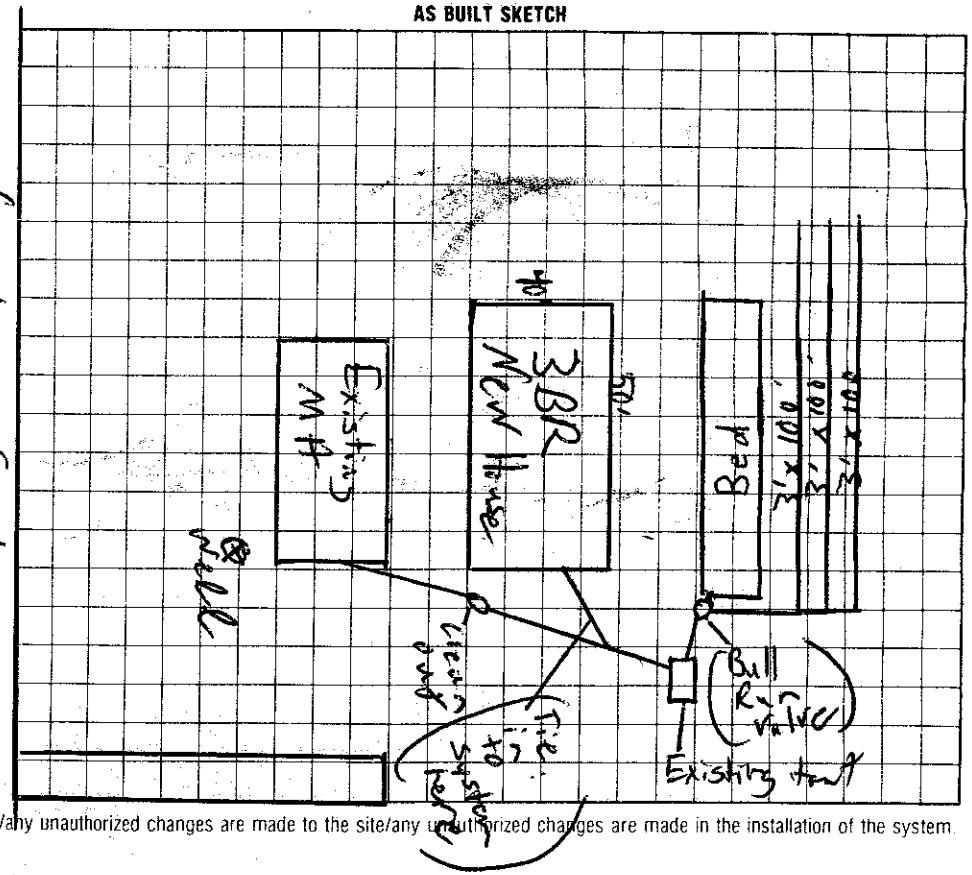

I understand that this permit can be suspended or revoked if any false information is supplied toward securing the permit/any unauthorized changes are made to the site/any unauthorized changes are made in the installation of the system.

Signed:

Improvement Permit by: date

Existing System Inspection by: C. Bobytown EHSI date 3/22/96

Installed by:

Certificate of Completion by: C date

Operation Permit by: date

HEALTH DEPT. COPY: WHITE INSPECTION COPY (FINAL): GREEN OWNER COPY (FINAL): YELLOW INSPECTION COPY (INITIAL): PINK OWNER COPY (INITIAL): GOLD