1:00 12:30

IREDELL COUNTY HEALTH DEPARTMENT - *ENVIRONMENTAL HEALTH* ☐ STATESVILLE OFFICE 704-878-5305 ☒ MOORESVILLE OFFICE 704-664-5281

IMPROVEMENT PERMIT / AUTHORIZATION TO CONSTRUCT / OPERATION PERMIT / EXISTING SYSTEM INSPECTION

PERMIT # 168285 PIN # 4627-60-7886 DATE 9-26-11

OWNER JAMES MORRIS APPLICANT: MARTY CARTER PHONE: Home/Cell # 336-940-2341 Business #

SITE ADDRESS 381 GRASSHOPPER CR. OWNER / APPLICANT ADDRESS SAME

SITE DIRECTIONS BSR, TR MCKENDREE, TR GRASSHOPPER CR. ON R

SUBDIVISION CL&T BLOCK / SECTION 8 LOT # 454 LOT AREA .89AC DESIGN FLOW 480 L.T.A.R. .3

Septic Tank EX. 1000 Gallons: STB Date

Pump Tank Gallons: P T Date

Pump Make Model Serial #

No. Nitrification Fields: 1 No. Lines 2 Linear Feet 200'

Trench Width 36" Max. Trench Bottom Depth 36"

☐ New System ☐ Repair ☒ Expansion System Type I II (III) IV V VI

System Description: 25% RED.

Repair System Description: PANEL

Maintenance Agreement Required ☐ YES ☒ NO

Gravel Depth — ☒ GRAVITY ☐ PRESSURE

☒ Residence ☐ Business ☐ Other ☐ Slab ☐ Basement w/plumbing


No. Bedrooms 4 No. Persons No. Employees ☒ Crawl Space ☐ Basement w/o plumbing

Water Supply: ☒ Private ☐ Public ☐ Community


Comments / Conditions ① USE EXISTING TANK ② ADD 2C 100' LINES ③ USE DROP BOX FOR DISTRIBUTION

1/4/2012 OK to add shower to "half" bath on main level - not near any "potential" bedrooms MD.

INITIAL SITE SKETCH

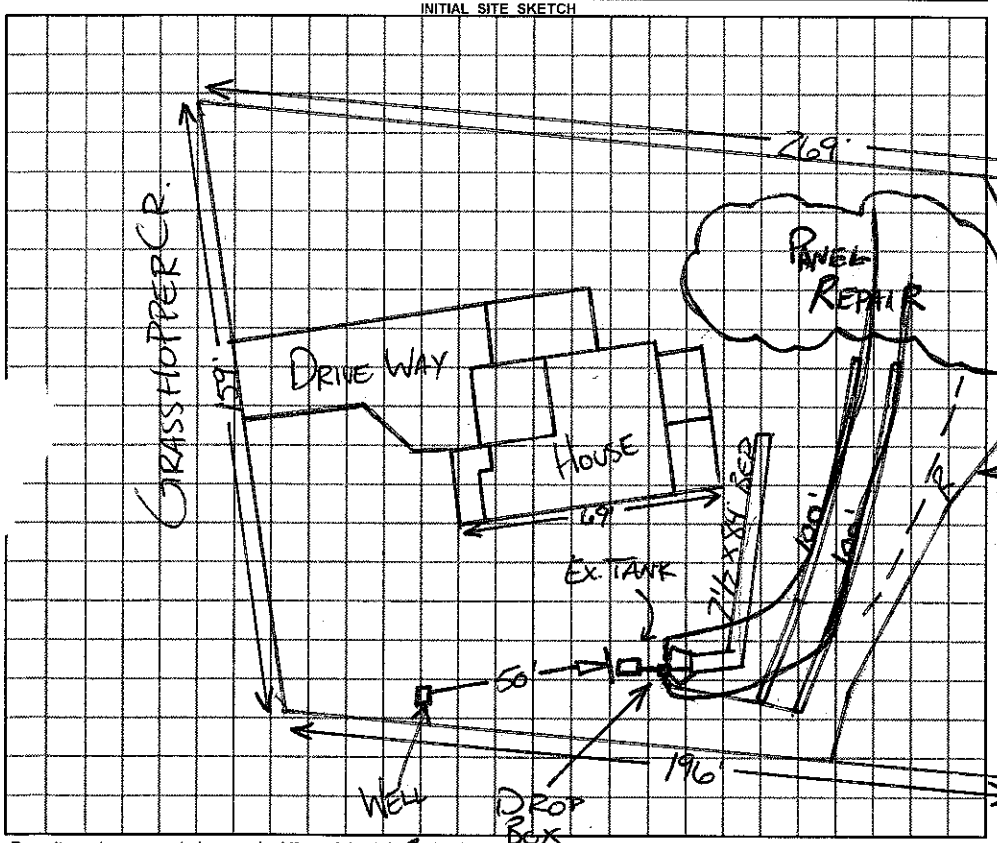

AS BUILT SKETCH

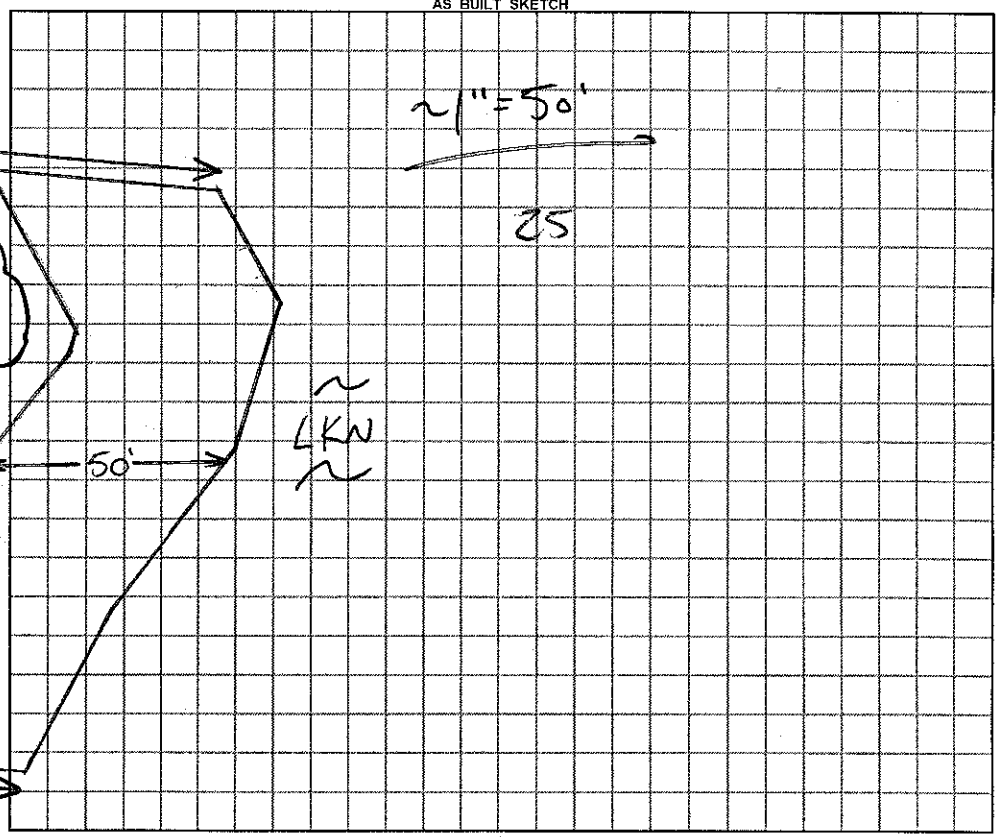

Permit can be suspended or revoked if any false information is supplied toward securing the permit / any unauthorized changes are made to the site / any unauthorized changes are made in the installation of the system.

☐ ***IMPROVEMENT PERMIT*** with plat valid without expiration. ☐ ***IMPROVEMENT PERMIT*** with plat valid without expiration. site plan valid 60 mo. ☒ ***AUTHORIZATION TO CONSTRUCT*** valid for period equal to IMPROVEMENT PERMIT--not to exceed 60 mo.

Owner / Applicant Signature: Mark C Carter VP CCB Date 10-10-11 Installed by: MARTY CARTER

IMPROVEMENT PERMIT by: ***REHS*** Date 10-10-11 OPERATION PERMIT by: ***REHS*** Date 4/12/12

AUTHORIZATION TO CONSTRUCT by: ***REHS*** Date 10-10-11 Existing System Inspec ***REHS*** Date

YOU SHOULD CONTACT A LOCATOR SERVICE PRIOR TO ANY EXCAVATION

White Copy – Envir YELLOW COPY (Final) Owner / Applicant PINK COPY (Initial) Owner / Applicant