EDELL COUNTY HEALTH DEPARTMENT

STATESVILLE 704-878-5305 MOORESVILLE 704-664-5281

IPROVEMENT PERMIT / AUTHORIZATION TO CONSTRUCT / OPERATION PERMIT / EXISTING SYSTEM INSPECTION

PERMIT# 1336602 PIN# 4627608400

OWNER OR APPLICANT Donald H. & Amanda K. Moore DATE 4-10-06

ADDRESS 254 Lucky Dr. Concord 28027 PHONE: Business 704-979-7610 Home 704-788-4759

LOCATION Brawley School Rd TR McKendree TR Grasshopper Circle (403 Grasshopper Circle)

SUBDIVISION NA CLT BLOCK / SECTION 8 LOT 457 LOT AREA .737 AC SITE CLASS. PS DESIGN FLOW 480gpd L.T.A.R. .3gpd/ft²

>28days

Septic Tank: 1000 Gallons; STB ~~750~~ 312 Date

Pump Tank: 1000 Gallons; PT 283 Date

Pump Make: Gould's Model PT 5IM Serial No.

Nitrification Field: No Fields 1 Square Feet 1600 Linear Feet 270

No Lines 6 Trench Width 24" min. Max Trench Bottom Depth 36" Gravel Depth NA

☒ New System ☐ Repair ☐ Expansion System Type: I II III IV V VI

System Description: LP Panel

Repair System Description: LP Panel

Maintenance Agreement Required: ☒ Yes ☐ No

☒ House/Mod. Home No. Bedrooms 4

☐ Mobile Home No. Persons

☐ Business No. Employees

☐ Other

Water Supply: ☒ Individual ☐ Public ☐ Community


☐ Gravity ☒ Pressure ☒ Slab ☐ Crawl Space ☒ Basement w/plumbing ☐ Basement wo/plumbing

62 panels

Comments/Conditions:
Properly abandon existing well before AC issued. Properly abandon existing system. NO foundation drain around garage. Keep water line 10'+ from system & repair


1" = 50'

INITIAL SITE SKETCH

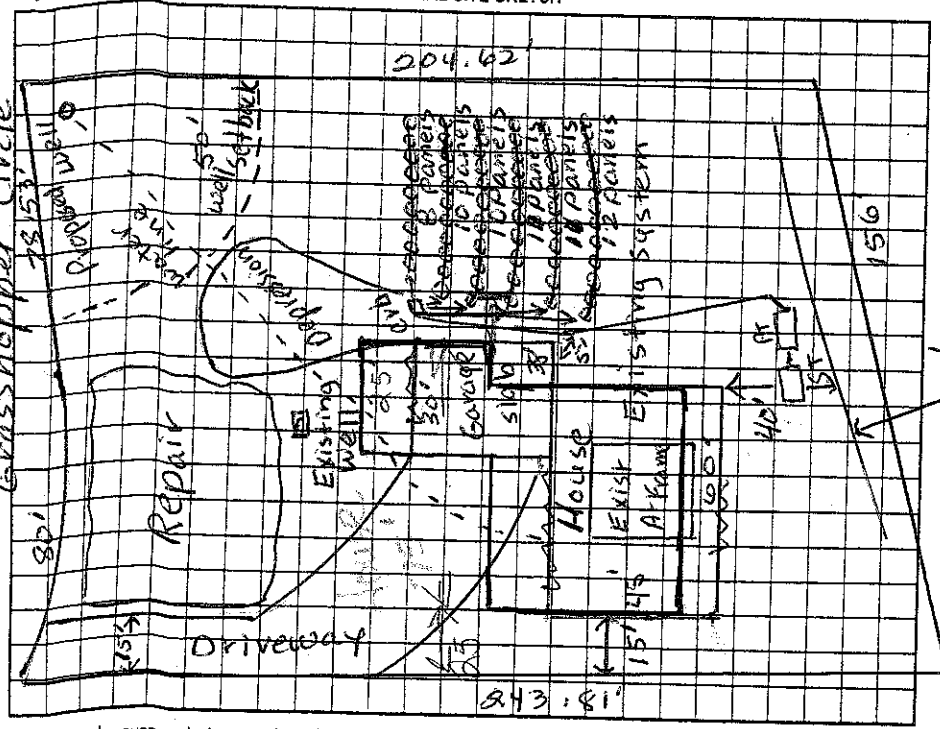

Comments/Conditions:
garage House
8/15/07 Checked Pres, elect & alarm
keep system 5' from depression, 5' from garage foundation, 15' from house

AS BUILT SKETCH

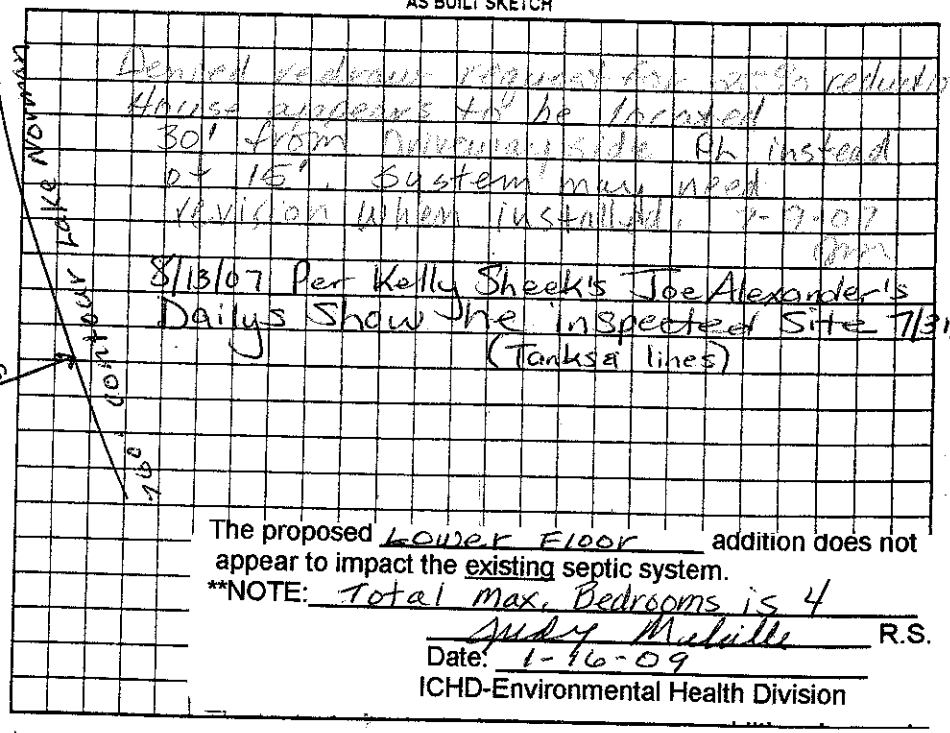

Permit can be suspended or revoked if any false information is supplied toward securing the permit/any unauthorized changes are made to the site/any unauthorized changes are made in the installation of the system. Improvement Permit ~~with plat~~ valid without expiration. ☐ Improvement Permit with site plan valid for sixty months ☒ Authorization to Construct is valid for a period equal to that of Improvement Permit – not to exceed sixty months.

Signed: Kim Dow date 4/13/06 Installed by: Richard Abernathy LPS

Improvement Permit by: Judy Melville date 4-10-06 Operation Permit by: Maria Hall Dow date 9/7/07

Authorization to Construct by: Judy Melville date 8-29-06 Existing System Inspection by: date

HEALTH DEPT. COPY: WHITE OWNER COPY (FINAL): YELLOW OWNER COPY (INITIAL): PINK