IREDELL COUNTY HEALTH DEPARTMENT

STATESVILLE 704-878-5305 MOORESVILLE 704-664-5281

IMPROVEMENT PERMIT / AUTHORIZATION TO CONSTRUCT / OPERATION PERMIT / EXISTING SYSTEM INSPECTION

PERMIT # 165568 PIN # 4627 61 2472 DATE 4-12-2011

OWNER or APPLICANT Coy Poteat PHONE: Business 704 819-9137 Home: 7048738584

OWNER or APPLICANT ADDRESS 2612 Eastbrook Ln. Statesville, NC 28625

LOCATION / DIRECTIONS Brawley School Rd TR McKendree TR Grasshopper Circle #301

SUBDIVISION CL&T BLOCK / SECTION 8 LOT # 440 LOT AREA .167 DESIGN FLOW 240gpd L.T.A.R.

Exist
Septic Tank 1000 Gallons: STB Date
Pump Tank Gallons: P T Date
Pump Make Model Serial #
Exist Nitrification Field No Fields 1 No Lines Linear Feet 225'
Bed Trench Width ~10' Max. Trench Bottom Depth — Gravel Depth —

☐ New System ☐ Repair ☐ Expansion System Type I II III IV V VI
System Description: Exist Gravity - Conventional Bed
Repair System Description:
Maintenance Agreement Required ☐ YES ☒ NO
☒ GRAVITY ☐ PRESSURE

☒ Residence No. Bedrooms 2
☐ Business No. Persons
☐ Other No. Employees
☐ Slab ☒ Crawl Space
☐ Basement w/plumbing ☐ Basement w/o plumbing

Water Supply
☒ Private
☐ Public
☐ Community


Comments / Conditions: Existing Septic System Appears to be Functioning Okay at time of inspection

★ Must keep any Buildings at least 5ft from Septic System.

Comments / Conditions: Note: Out Croppings of Huge Boulders all over Mtg.

INITIAL SITE SKETCH

Scale ~ 1:50

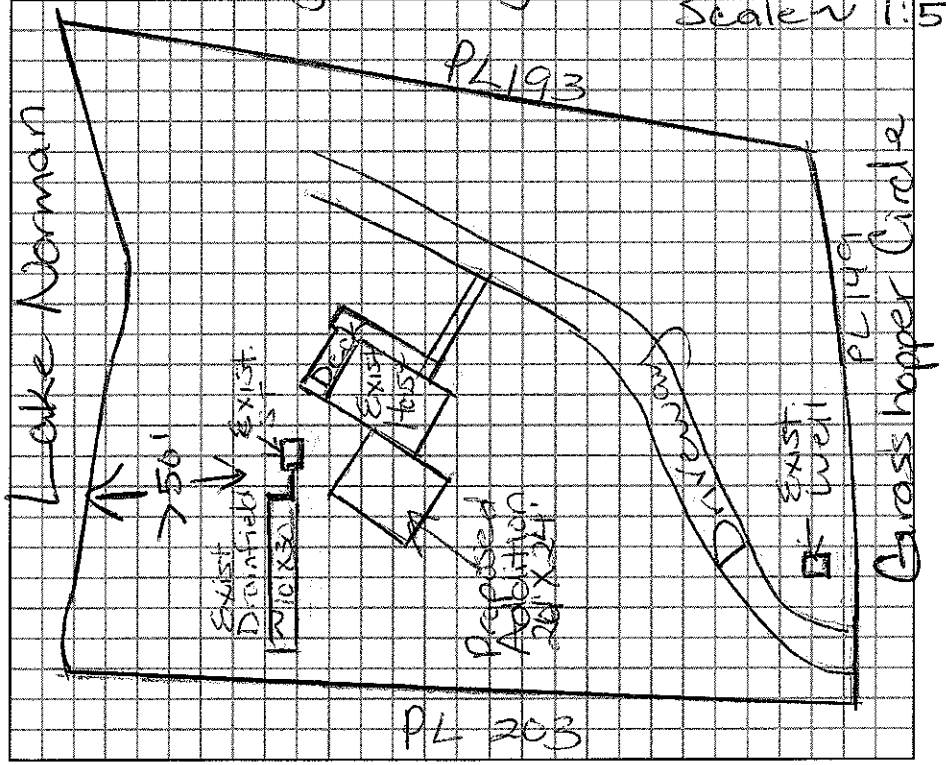

AS BUILT SKETCH

Permit can be suspended or revoked if any false information is supplied toward securing the permit / any unauthorized changes are made to the site / any unauthorized changes are made in the installation of the system.

☐ *IMPROVEMENT PERMIT w / plat valid without expiration.* ☐ *IMPROVEMENT PERMIT w / site plan valid for 60 mos.* ☐ *AUTHORIZATION TO CONSTRUCT valid for period equal to IMPROVEMENT PERMIT-not to exceed 60 mo.*

Owner / Applicant Signature: Coy E Poteat Date 4-18-11

Improvement Permit by: Date

Authorization to Construct by: Date

YOU SHOULD CONTACT A LOCATOR SERVICE PRIOR TO ANY EXCAVATION.

Installed by: April 1965

Operation Permit by: Date:

Existing System Inspected by: REHS Date: 4/12/11

WHITE COPY Environmental Health YELLOW COPY (Final) Owner / Applicant PINK COPY (Initial) Owner / Applicant