Site Address: 306 Grasshopper Cir., Mrsvl.

3:00

IREDELL COUNTY HEALTH DEPARTMENT

STATESVILLE 704-878-5305 MOORESVILLE 704-664-5281

IMPROVEMENT PERMIT / AUTHORIZATION TO CONSTRUCT / OPERATION PERMIT / EXISTING SYSTEM INSPECTION

PERMIT# ~~13937021532~~2 PIN# ~~4626581943.605~~ 4627615455. ✓ DATE 4-18-07

OWNER OR APPLICANT The Farms LLC / Kearey Builders PHONE: Business _____ Home _____

ADDRESS 2214 Brawley School Rd Mooresville NC 28117

LOCATION Brawley School Rd TR McKendree TR Grasshopper Circle in Loop

SUBDIVISION The Farms BLOCK / SECTION 5 LOT 605/605B LOT AREA .82Ac SITE CLASS. PS DESIGN FLOW 480gpd L.T.A.R. .25 gpd/ft2

✓

Septic Tank: 1500 # Gallons: STB Plastic Infiltrator Date _____

Pump Tank: 1500 # Gallons: PT _____ Date _____

Pump Make Goulds Model WE0712HC Serial No. C116570C4

Nitrification Field: No Fields 1 Square Feet _____ Linear Feet 480

No Lines 6@80' Trench Width 36" Max Trench Bottom Depth 36" Gravel Depth N/A ☐ Gravity ☑ Pressure

☑ New System ☐ Repair ☐ Expansion System Type: I II (III) IV V VI

System Description: 25% reduction pm

Repair System Description: LP PPBPS

Maintenance Agreement Required: ☐ Yes ☒ No

☑ House/Mod. Home ☐ Mobile Home ☐ Business ☐ Other

No. Bedrooms 4 No. Persons 8 No. Employees _____

Water Supply: ☐ Individual ☒ Public ☒ Community

☐ Slab ☒ Crawl Space ☐ Basement w/plumbing ☐ Basement wo/plumbing

Comments/Conditions: # Per plan specs

Before AC verify elevations

Comments/Conditions: 12/11/15 Reviewed Floor plans, in compliance with Septic plan. 6/9/16 Checked tanks, lines, supply line & pm

INITIAL SITE SKETCH

See Plan from S&ME

AS BUILT SKETCH

	Date	Initials
Drain Lines Checked	6/9/16	MD
Tanks Checked & Supply line	6/9/16	MD
Pressure Manifold or Valve Box Checked	6-23	BA
Pressure Head Set	6-23	BA
Electrical Checked	8-10-16	[illegible]
Floats Set	6-23	BA
Alarm Checked	6-23	BA
Maintenance Contract Y/ (N)		


Permit can be suspended or revoked if any false information is supplied toward securing the permit/any unauthorized changes are made to the site/any unauthorized changes are made in the installation of the system. Improvement Permit with plat valid without expiration ☐ Improvement Permit with site plan valid for sixty months ☒ Authorization to Construct is valid for a period equal to that of Improvement Permit – not to exceed sixty months.

Signed: _____ date 4-30-07 Installed by: Tommy Frye


Improvement Permit by: Judy Melville date 4-18-07 Operation Permit by: BA date APPROVED JUN 23 2016

Authorization to Construct by: Mark Dotson RS date 12/11/15 Existing System Inspection by: _____ date _____

HEALTH DEPT. COPY: WHITE OWNER COPY (FINAL): YELLOW OWNER COPY (INITIAL): PINK

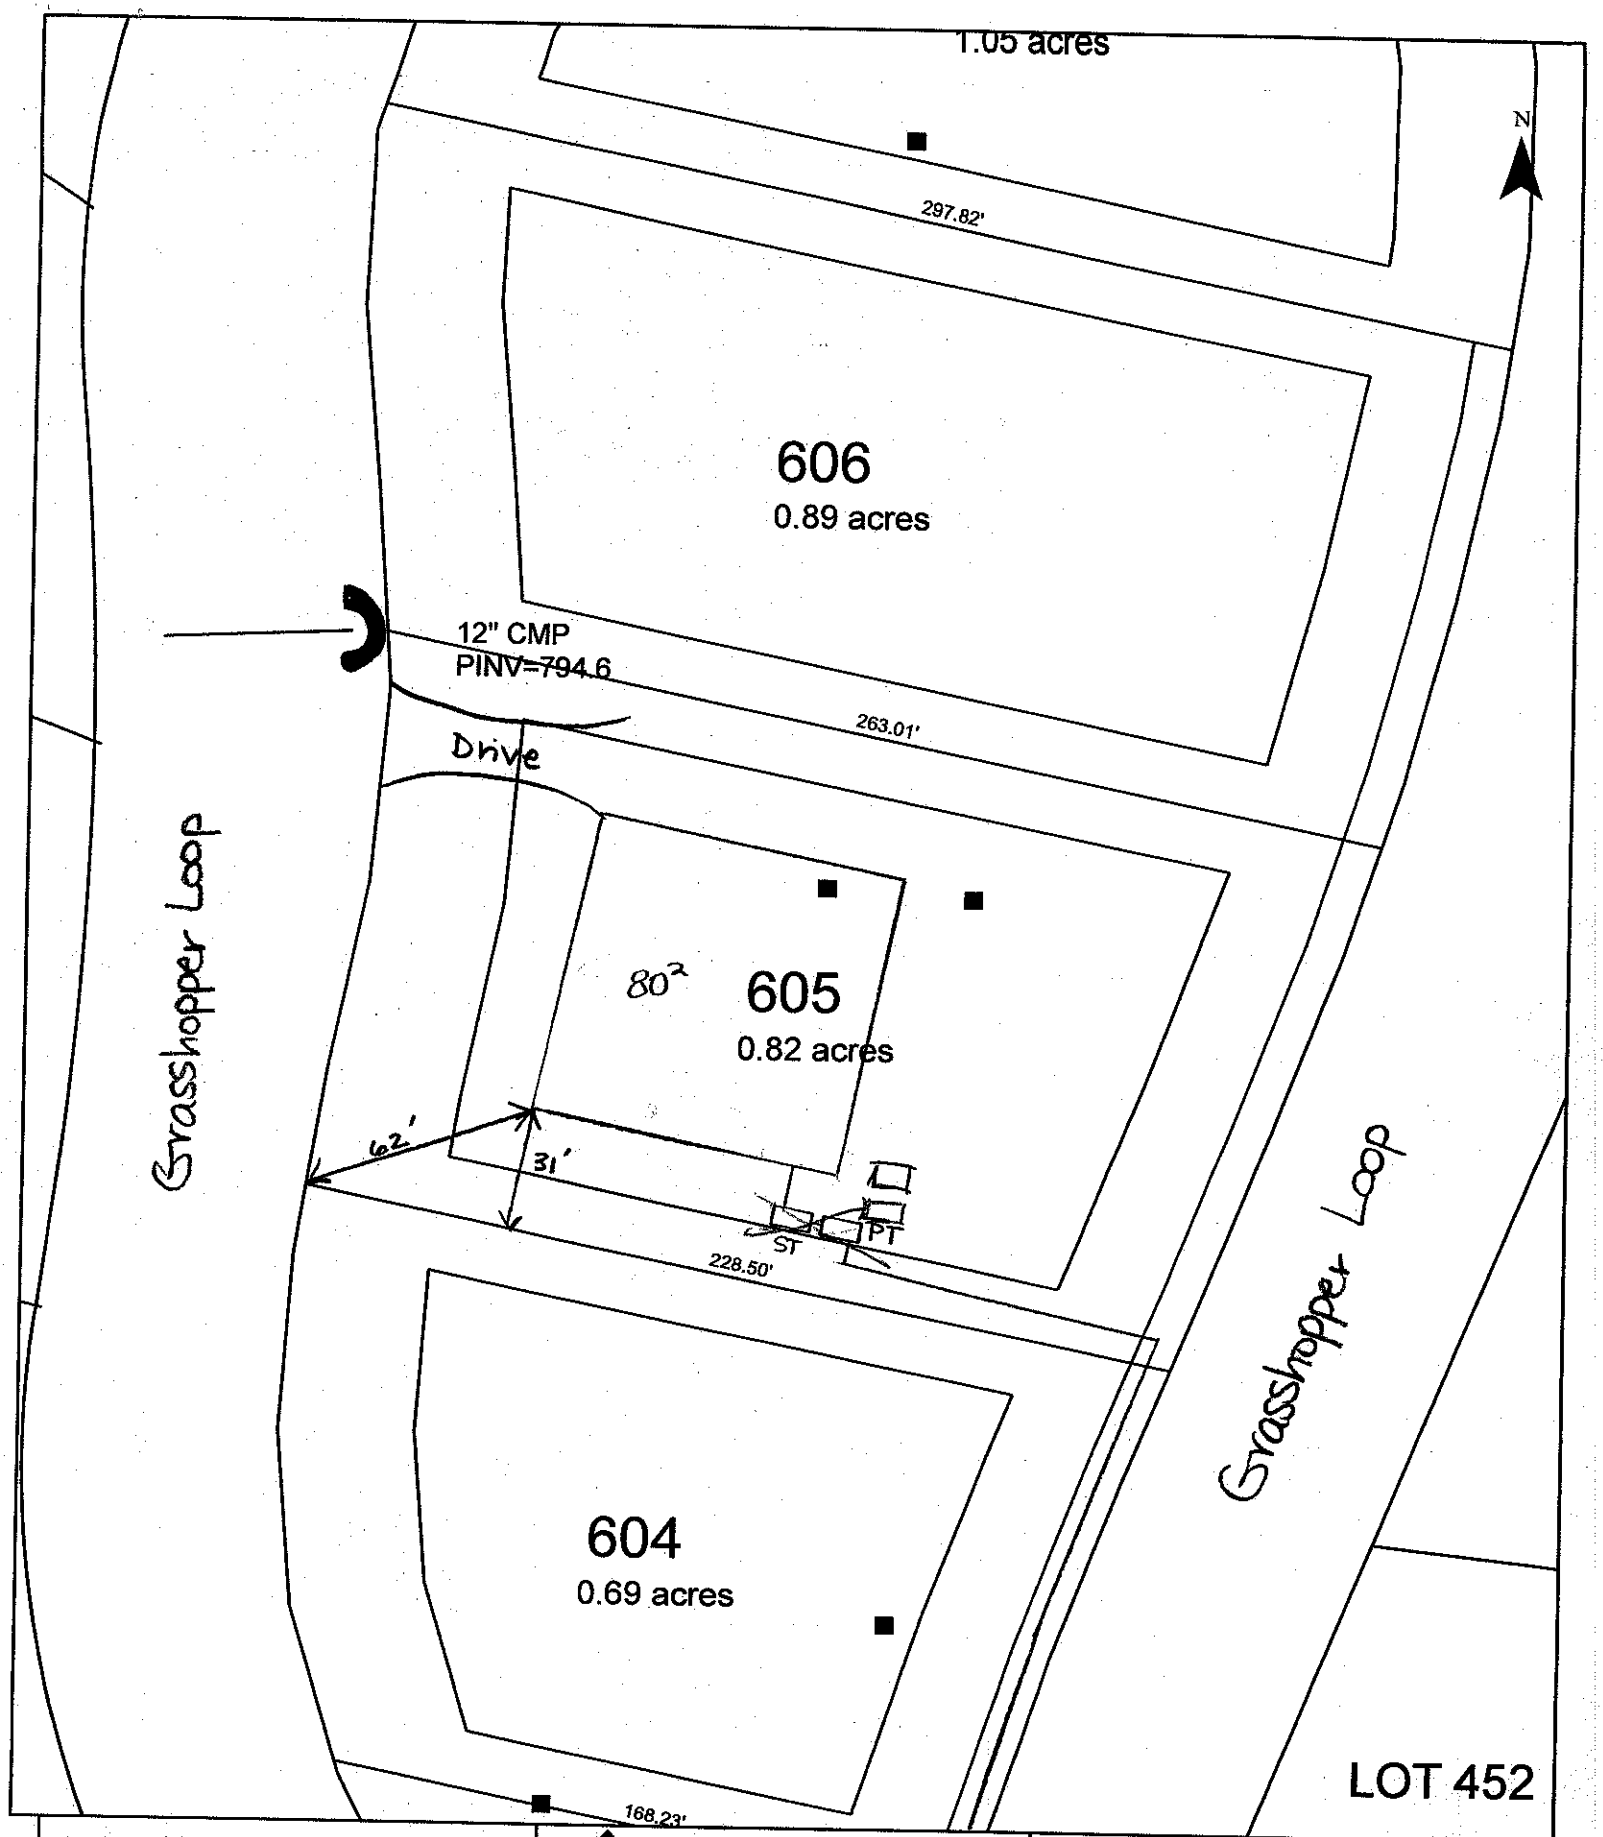

Scale: 1 inch equals 50 feet	S&ME	The Farms - Phase V	FIGURE
Drawn by: JBP	ENVIRONMENTAL SERVICES • ENGINEERING • TESTING	Lot 605	1
Reviewed by: KS		Iredell County, NC	
Date: February, 2007		S&ME Project #1588-05-070	

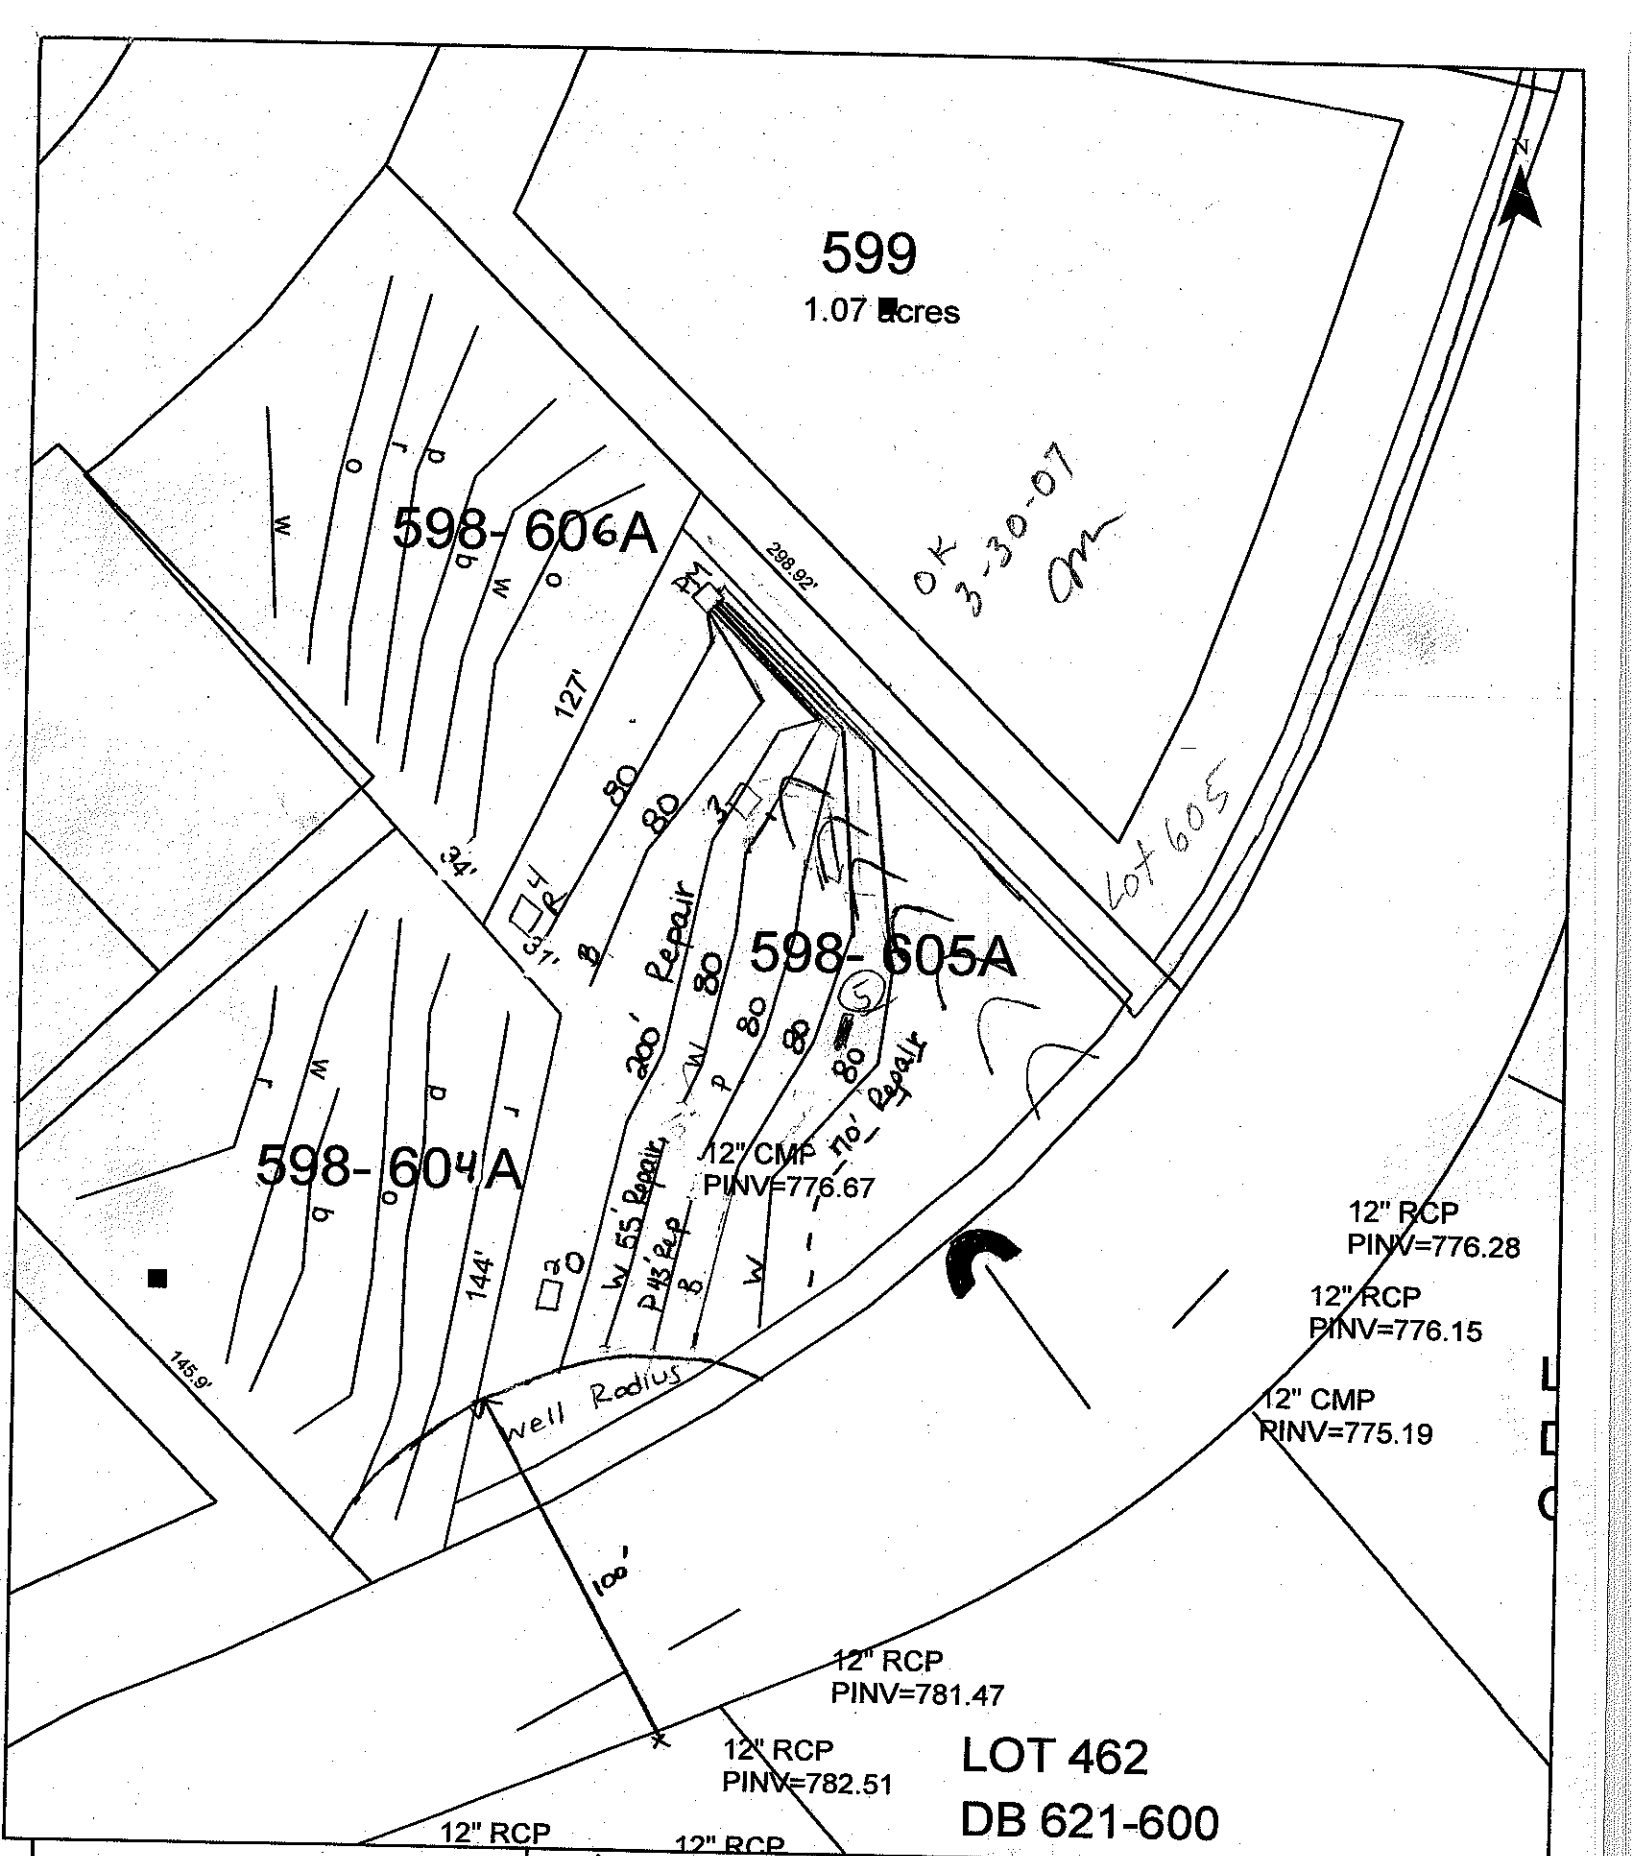

Scale: 1 inch equals 50 feet	S&ME	The Farms - Phase V	FIGURE
Drawn by: JBP		Lot 605	2
Reviewed by: KS		Iredell County, NC	
Date: February, 2007	ENVIRONMENTAL SERVICES • ENGINEERING • TESTING	S&ME Project #1588-05-070	