4627615924

IREDELL COUNTY HEALTH DEPARTMENT

STATESVILLE 704-878-5305 MOORESVILLE 704-664-5281

IMPROVEMENT PERMIT / CERTIFICATE OF COMPLETION / OPERATION PERMIT / EXISTING SYSTEM INSPECTION

PROPERTY DESCRIPTION NO. 17442 DATE March 31, '94 TAX MAP NO. 2L2A444

OWNER OR CONTRACTOR John Dawson PHONE: Business _____ Home _____ Watershed: ☑ Yes ☐ No L.N.

ADDRESS [redacted] Apt 165 I 151 Heywood Dr. Spartanburg SC 29302

LOCATION 1100 TR 1115 TR 1215 Bear Rt at Forks on Right a midway

SUBDIVISION Crescent LN BLOCK / SECTION 8 LOT 444 LOT AREA Existing SITE CLASS. 3 DESIGN FLOW _____ L.T.A.R. _____

Septic Tank: Existing Gallons; STB _____ Date _____

Pump Tank: _____ Gallons; PT _____ Date _____

Pump Make: _____ Model _____ Serial No. _____

Nitrification Field: No Fields Existing Square Feet _____ Linear Feet _____

No Lines _____ Trench Width _____ Max Trench Bottom Depth _____ Gravel Depth _____

☐ New System ☐ Repair System Type: I, II, III, IV, V, VI

System Description: _____

Repair System Description: _____

Maintenance Agreement Required: ☐ Yes ☐ No

☑ House/Mod. Home No. Bedrooms ____

☐ Mobile Home No. Bathrooms ____

☐ Business No. Employees ____

☐ Other _____


☐ Slab ☐ Crawl Space ☐ Basement w/plumbing ☐ Basement wo/plumbing

Water Supply:
☑ Individual
☐ Community
☐ Public


Comments: Kitchen addition only.
No sign of septic system malfunction.
No increase in sewage flow.

Comments:

INITIAL SITE SKETCH

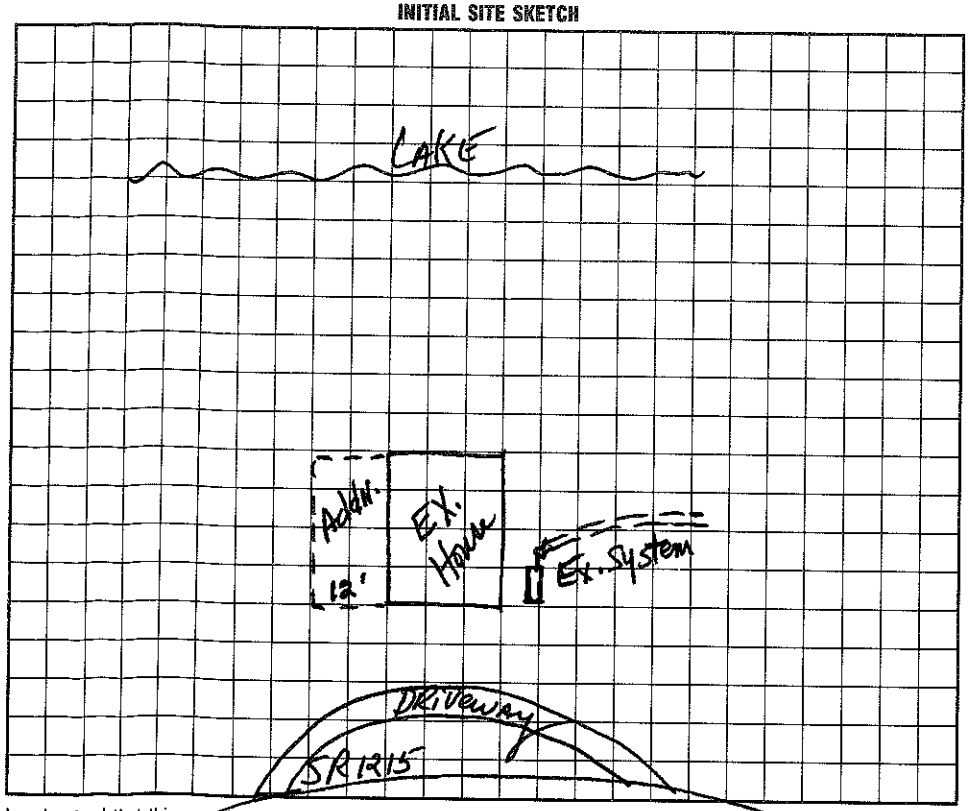

AS BUILT SKETCH

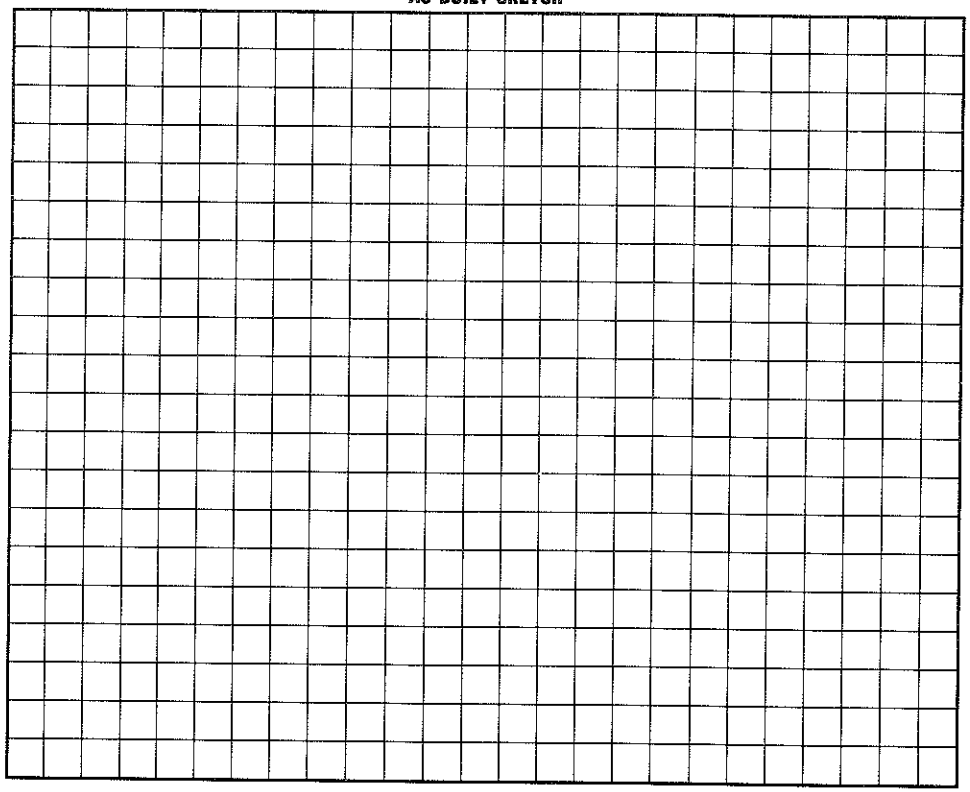

I understand that this permit can be suspended or revoked if any false information is supplied toward securing the permit/any unauthorized changes are made to the site/any unauthorized changes are made in the installation of the system. Improvement Permit is valid for 60 months from date of issuance.

Signed: _____

Improvement Permit by: _____ date _____

Existing System Inspection by: David R Hinson, RS date 3/31/94

Installed by: _____

Certificate of Completion by: _____ date _____

Operation Permit by: _____ date _____

HEALTH DEPT. COPY: WHITE INSPECTION COPY (FINAL): GREEN OWNER COPY (FINAL): YELLOW INSPECTION COPY (INITIAL): PINK OWNER COPY (INITIAL): GOLD