IREDELL COUNTY HEALTH DEPARTMENT

STATESVILLE 704-878-5305 MOORESVILLE 704-664-5281

IMPROVEMENT PERMIT / CERTIFICATE OF COMPLETION / OPERATION PERMIT / EXISTING SYSTEM INSPECTION

PROPERTY DESCRIPTION NO. 4627617062 DATE 3-20-95 TAX MAP NO. Watershed: ☐ Yes ☐ No

OWNER OR CONTRACTOR Andy Moscarelli PHONE: Business Home 664-3842 Lake Norman

ADDRESS 373 Grass Hopper Circle

LOCATION Branches School Rd TR McKendree Chapel Rd Rt Grasshopper Rd Forks 3/4 mi Rt

SUBDIVISION Lake Norman BLOCK / SECTION 5 LOT 453 LOT AREA ample SITE CLASS. #5 DESIGN FLOW 480 L.T.A.R. 1.4

Septic Tank: EX Gallons; STB Date

Pump Tank: Gallons; PT Date

Pump Make: Model Serial No.

Nitrification Field: No Fields 2 Square Feet 675 Linear Feet 225

No Lines 3 Trench Width 108" Max Trench Bottom Depth 36" Gravel Depth 18"

☐ New System ☑ Repair System Type: I, II, III, IV, V, VI

System Description:

Repair System Description: Conv Equity

Maintenance Agreement Required: ☐ Yes ☑ No

☑ House/Mod. Home No. Bedrooms 4

☐ Mobile Home No. Bathrooms 3

☐ Business No. Employees

☐ Other


☐ Slab ☐ Crawl Space ☐ Basement w/plumbing ☑ Basement wo/plumbing

Water Supply: ☑ Individual ☐ Community ☐ Public


Comments: use 3" solid line from EX field to new field.

Comments: Original System Installed 1975 under Balentine

INITIAL SITE SKETCH

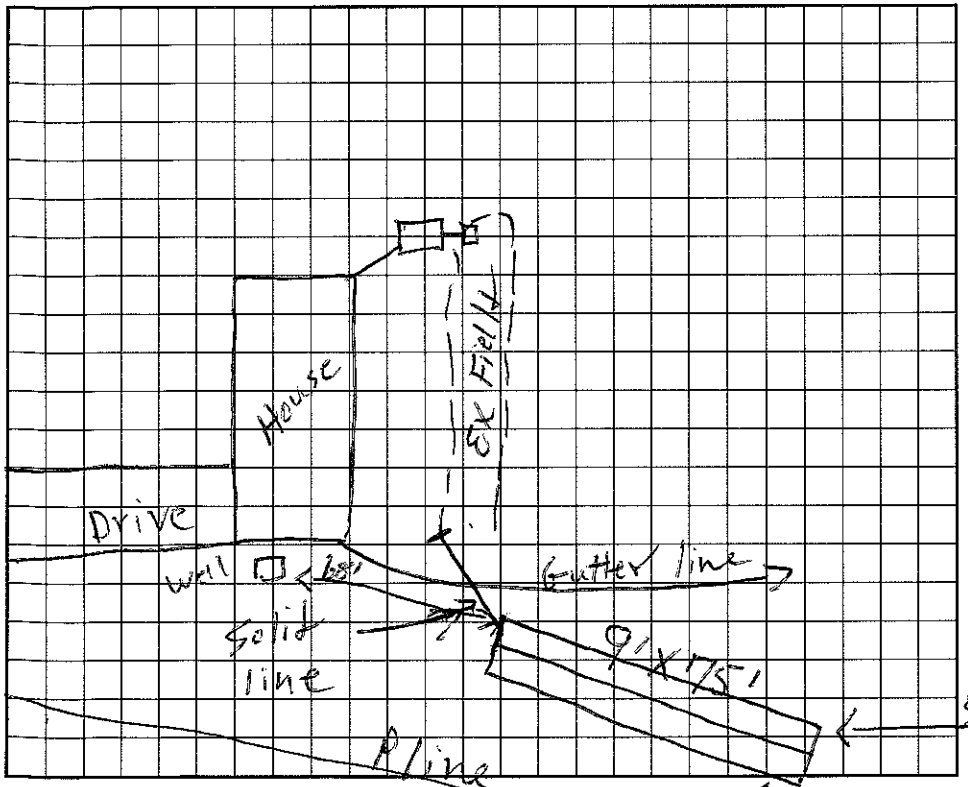

AS BUILT SKETCH

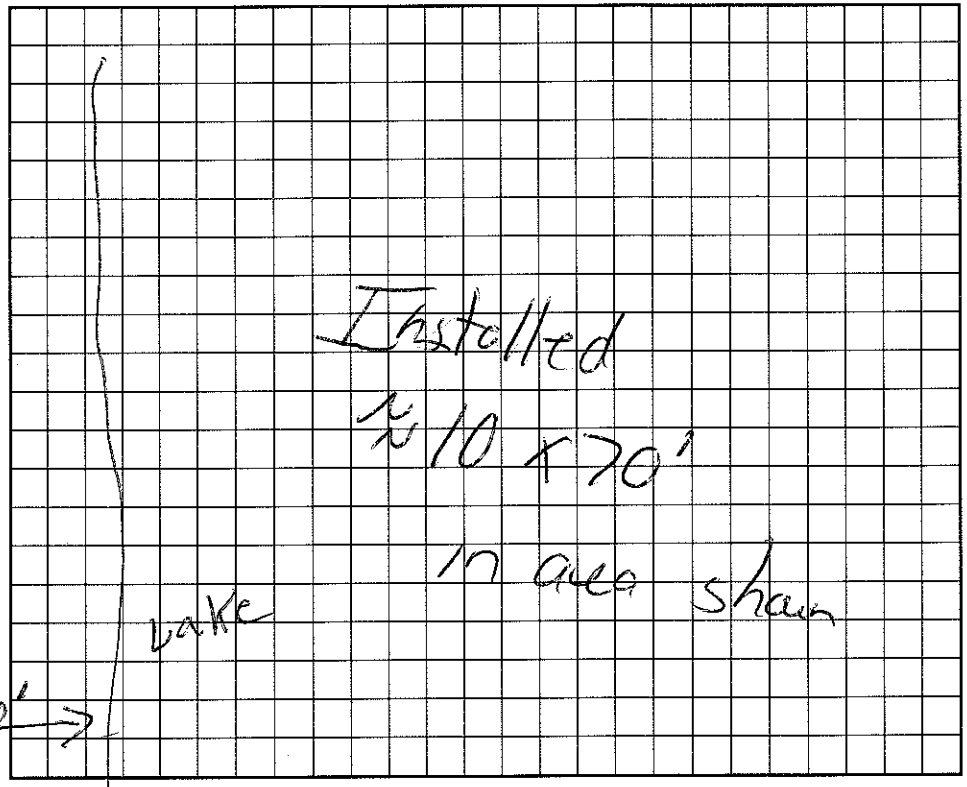

I understand that this permit can be suspended or revoked if any false information is supplied toward securing the permit/any unauthorized changes are made to the site/any unauthorized changes are made in the installation of the system. Improvement Permit is valid for 60 months from date of issuance.

Signed: Andy Moscarelli Installed by: AAA Enterprises

Improvement Permit by: L.C. Moore date 3-20-95 Certificate of Completion by: date 3/29/95

Existing System Inspection by: date Operation Permit by: date

HEALTH DEPT. COPY: WHITE INSPECTION COPY (FINAL): GREEN OWNER COPY (FINAL): YELLOW INSPECTION COPY (INITIAL): PINK OWNER COPY (INITIAL): GOLD