IREDELL COUNTY HEALTH DEPARTMENT

STATESVILLE 704-878-5305 MOORESVILLE 704-664-5281

IMPROVEMENT PERMIT / AUTHORIZATION TO CONSTRUCT / OPERATION PERMIT / EXISTING SYSTEM INSPECTION

PERMIT # 158652 PIN # 4627618683 DATE

OWNER or APPLICANT Shawn Ogden Construct PHONE: Business Home:

OWNER or APPLICANT ADDRESS

LOCATION / DIRECTIONS Brawley School TR McKendree TR Grasshopper on Rt #343

SUBDIVISION Left BLOCK / SECTION 8 LOT # 449 LOT AREA .57 Acre DESIGN FLOW 360gpd L.T.A.R.

Septic Tank 1000 Gallons: STB 794 Date 3-9-10 ☒ New System ☐ Repair ☒ Expansion System Type I II III IV V VI

Pump Tank Gallons: P T Date System Description Gravity - 25% Reduct

Pump Make Model Serial # Repair System Description: Panel Blk

Nitrification Field No Fields 1 No Lines 6 Linear Feet 300ft Maintenance Agreement Required ☐ YES ☐ NO

Trench Width 36" Max. Trench Bottom Depth Gravel Depth N/A ☒ GRAVITY ☐ PRESSURE


☐ Residence No. Bedrooms ☐ Business No. Persons ☐ Other No. Employees ☐ Slab ☐ Crawl Space ☐ Basement w/plumbing ☐ Basement w/o plumbing

Water Supply ☐ Private ☐ Public ☐ Community


Comments / Conditions

Comments / Conditions

INITIAL SITE SKETCH

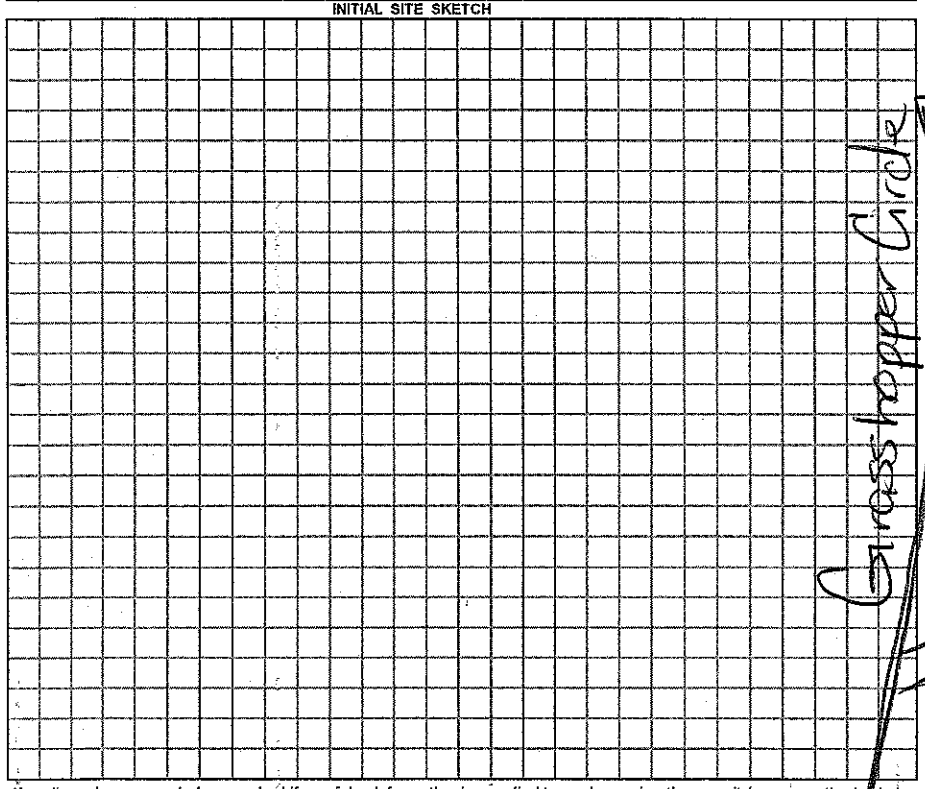

AS BUILT SKETCH

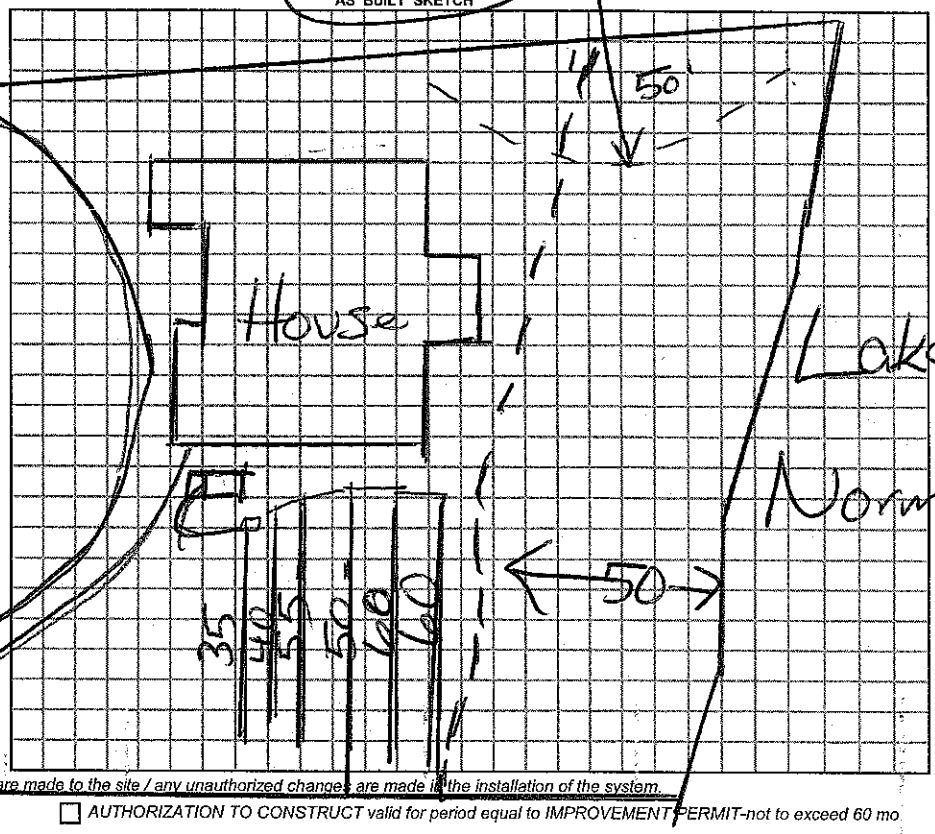

Permit can be suspended or revoked if any false information is supplied toward securing the permit / any unauthorized changes are made to the site / any unauthorized changes are made in the installation of the system.

☐ *IMPROVEMENT PERMIT w / plat valid without expiration.* ☐ *IMPROVEMENT PERMIT w / site plan valid for 60 mos.* ☐ *AUTHORIZATION TO CONSTRUCT valid for period equal to IMPROVEMENT PERMIT-not to exceed 60 mo.*

Owner / Applicant Signature: Date

Improvement Permit by: Date

Authorzation to Construct by: Date

Installed by:

Operation Permit by: Date:

Existing System Inspected by: Date:

YOU SHOULD CONTACT A LOCATOR SERVICE PRIOR TO ANY EXCAVATION.

WHITE COPY Environmental Health YELLOW COPY (Final) Owner / Applicant PINK COPY (Initial) Owner / Applicant

IREDELL COUNTY HEALTH DEPARTMENT

STATESVILLE 704-878-5305 MOORESVILLE 704-664-5281

11:30

IMPROVEMENT PERMIT / AUTHORIZATION TO CONSTRUCT / OPERATION PERMIT / EXISTING SYSTEM INSPECTION

PERMIT # 158652 PIN # 4627018683 Hugh Abrams DATE 11-23-09

OWNER or APPLICANT Shaun Odgen Construct PHONE: Business 704-309-6810 Home:

OWNER or APPLICANT ADDRESS P.O. Box 1281 Davidson NC 28036

LOCATION / DIRECTIONS Brawley School Rd TR McKendree TR Grasshopper on Rt. # 343

SUBDIVISION CLAT J BLOCK / SECTION 8 LOT # 449 LOT AREA .57Ac DESIGN FLOW 360gpd L.T.A.R. .3

Septic Tank 1600 Gallons: STB 794 Date 3-9-10

Pump Tank Gallons: PT Date

Pump Make Model Serial #

Nitrification Field No Fields 1 No Lines 4 Linear Feet 200'

Trench Width 36" Max. Trench Bottom Depth 36" Gravel Depth N/A

☐ New System ☐ Repair ☒ Expansion System Type I II III IV V VI

System Description: Gravity-Conv / 25% Reduction

Repair System Description: Panel Block / Pump

Maintenance Agreement Required ☐ YES ☒ NO


☐ GRAVITY ☐ PRESSURE

☐ Residence No. Bedrooms 3 ☐ Business No. Persons ☐ Other No. Employees ☐ Slab ☐ Crawl Space ☒ Basement w/plumbing ☐ Basement w/o plumbing

Water Supply: ☒ Private ☐ Public ☐ Community


Comments / Conditions * Add to Remainder of Exist. Bed. (74x50) Incorporate Exist Bed w/ New lines Scale 1:40 Use drop boxes * Neighbor's Well

INITIAL SITE SKETCH

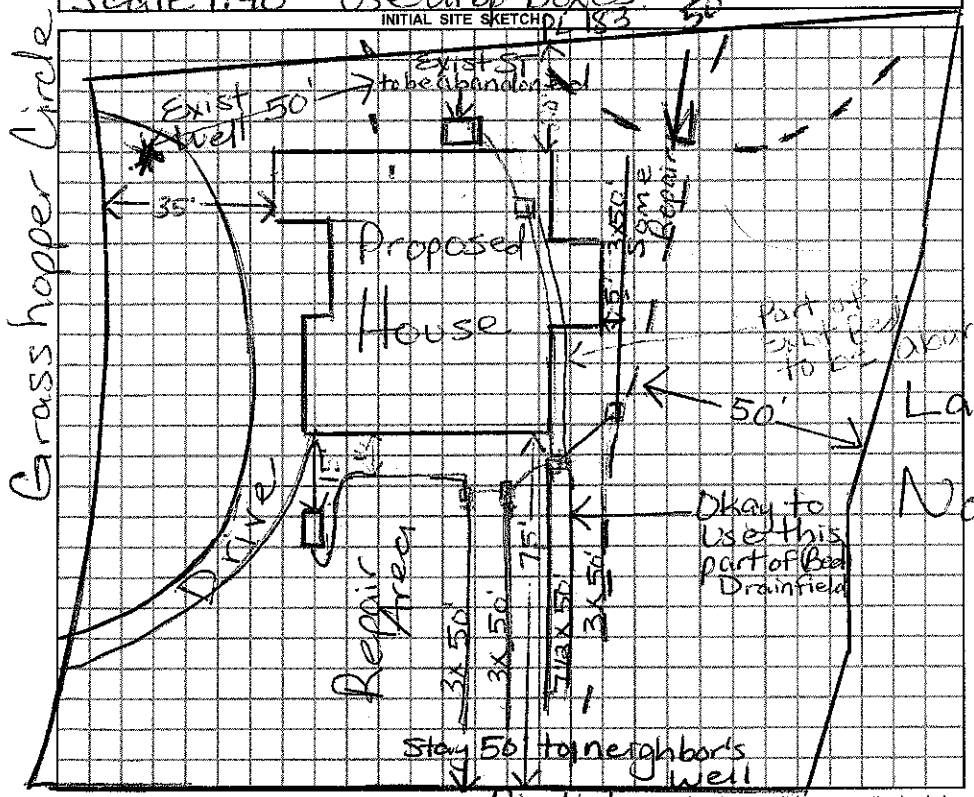

Comments / Conditions Builder/owner wants to use Grinder pump for Basement Plumbing. Keep Septic System at least 50ft from any well.

AS BUILT SKETCH

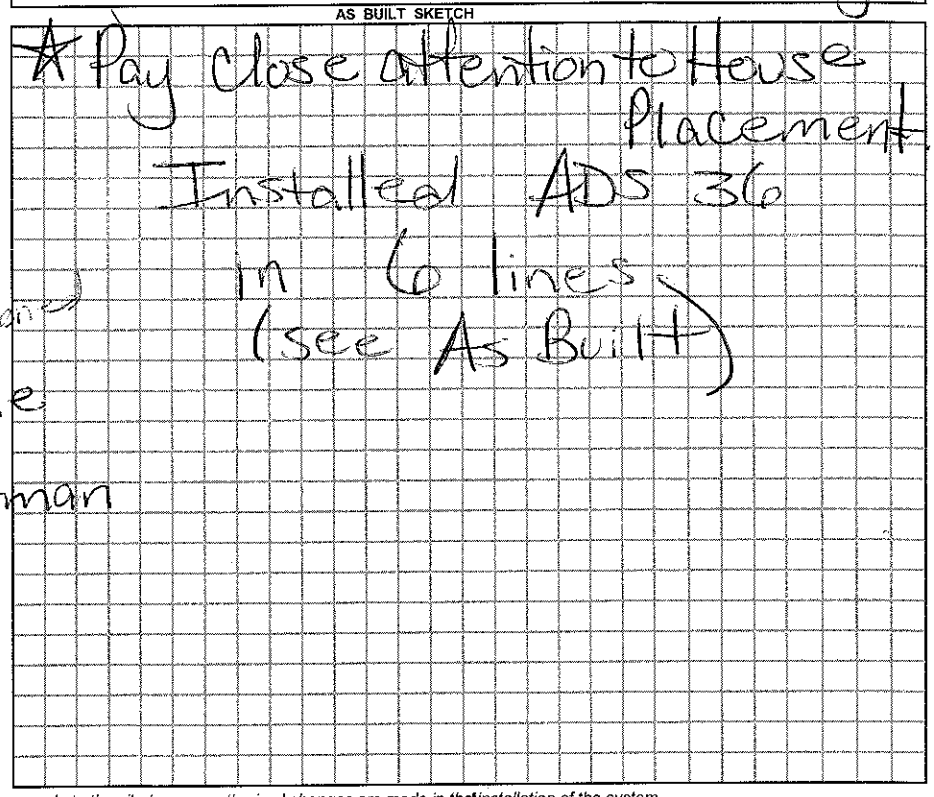

Permit can be suspended or revoked if any false information is supplied toward securing the permit / any unauthorized changes are made to the site / any unauthorized changes are made in the installation of the system.

☐ *IMPROVEMENT PERMIT w / plat valid without expiration.* ☐ *IMPROVEMENT PERMIT w / site plan valid for 60 mos.* ☐ *AUTHORIZATION TO CONSTRUCT valid for period equal to IMPROVEMENT PERMIT-not to exceed 60 mo.*

Owner / Applicant Signature: Date 12-2-09

Improvement Permit by: Maria H. Odgen BS Date 11/30/09

Authorzation to Construct by: Maria H. Odgen BS Date 12/2/09

Installed by: Richard Abernathy Date 4/14/10

Operation Permit by: Maria H. Odgen BS Date:

Existing System Inspected by: Date:

YOU SHOULD CONTACT A LOCATOR SERVICE PRIOR TO ANY EXCAVATION.

WHITE COPY Environmental Health YELLOW COPY (Final) Owner / Applicant PINK COPY (Initial) Owner / Applicant