4627618925

IREDELL COUNTY HEALTH DEPARTMENT

STATESVILLE 704-878-5305 MOORESVILLE 704-664-5281

IMPROVEMENT PERMIT / CERTIFICATE OF COMPLETION / OPERATION PERMIT / EXISTING SYSTEM INSPECTION

PROPERTY DESCRIPTION NO. 17113 DATE Sept. 28, '93 TAX MAP NO. 2L2A 447

OWNER OR CONTRACTOR Bob Stilp PHONE: Business (919) 760-4322 Home

ADDRESS 1883 Burke Mill Rd. Winston Salem, NC 27103

LOCATION 1100 TR JHS TR 1215 Bear Rt at fork TR Tweed Place on Right

SUBDIVISION Crescent Lake Norman BLOCK / SECTION 8 LOT 447 LOT AREA .81Ac SITE CLASS. PS for 1956 L.T.A.R. .23

Water Supply: ☑ Individual ☐ Community ☐ Public

Septic Tank: 1000 Gallons; STB 760 Strong Date 11-3-96

Pump Tank: ______ Gallons; PT ______ Date ______

Nitrification Field: No Fields 1 Square Feet ~~1110~~ 1200 Linear Feet ~~400~~ 370

No Lines 3 Trench Width 36" Trench Depth 24-36" Gravel Depth 12"

☑ New System ☐ Repair System Type: I, (II), III, IV, V, VI

System Description: gravity conventional

Repair System Description: LP PPBPS

Maintenance Agreement Required: ☐ Yes ☑ No

☑ House/Mod. Home No. Bedrooms 3 Garbage Disposal: ☐ Yes ☑ No

☐ Mobile Home No. Bathrooms 2 Auto. Dishwasher: ☑ Yes ☐ No


☐ Business No. Employees ______ Auto. Washing Machine: ☑ Yes ☐ No

☐ Other ______ Other ______


☐ Slab ☐ Crawl Space ☑ Basement w/plumbing ☐ Basement wo/plumbing

Comments: follow contour with nitrification field

INITIAL SITE SKETCH

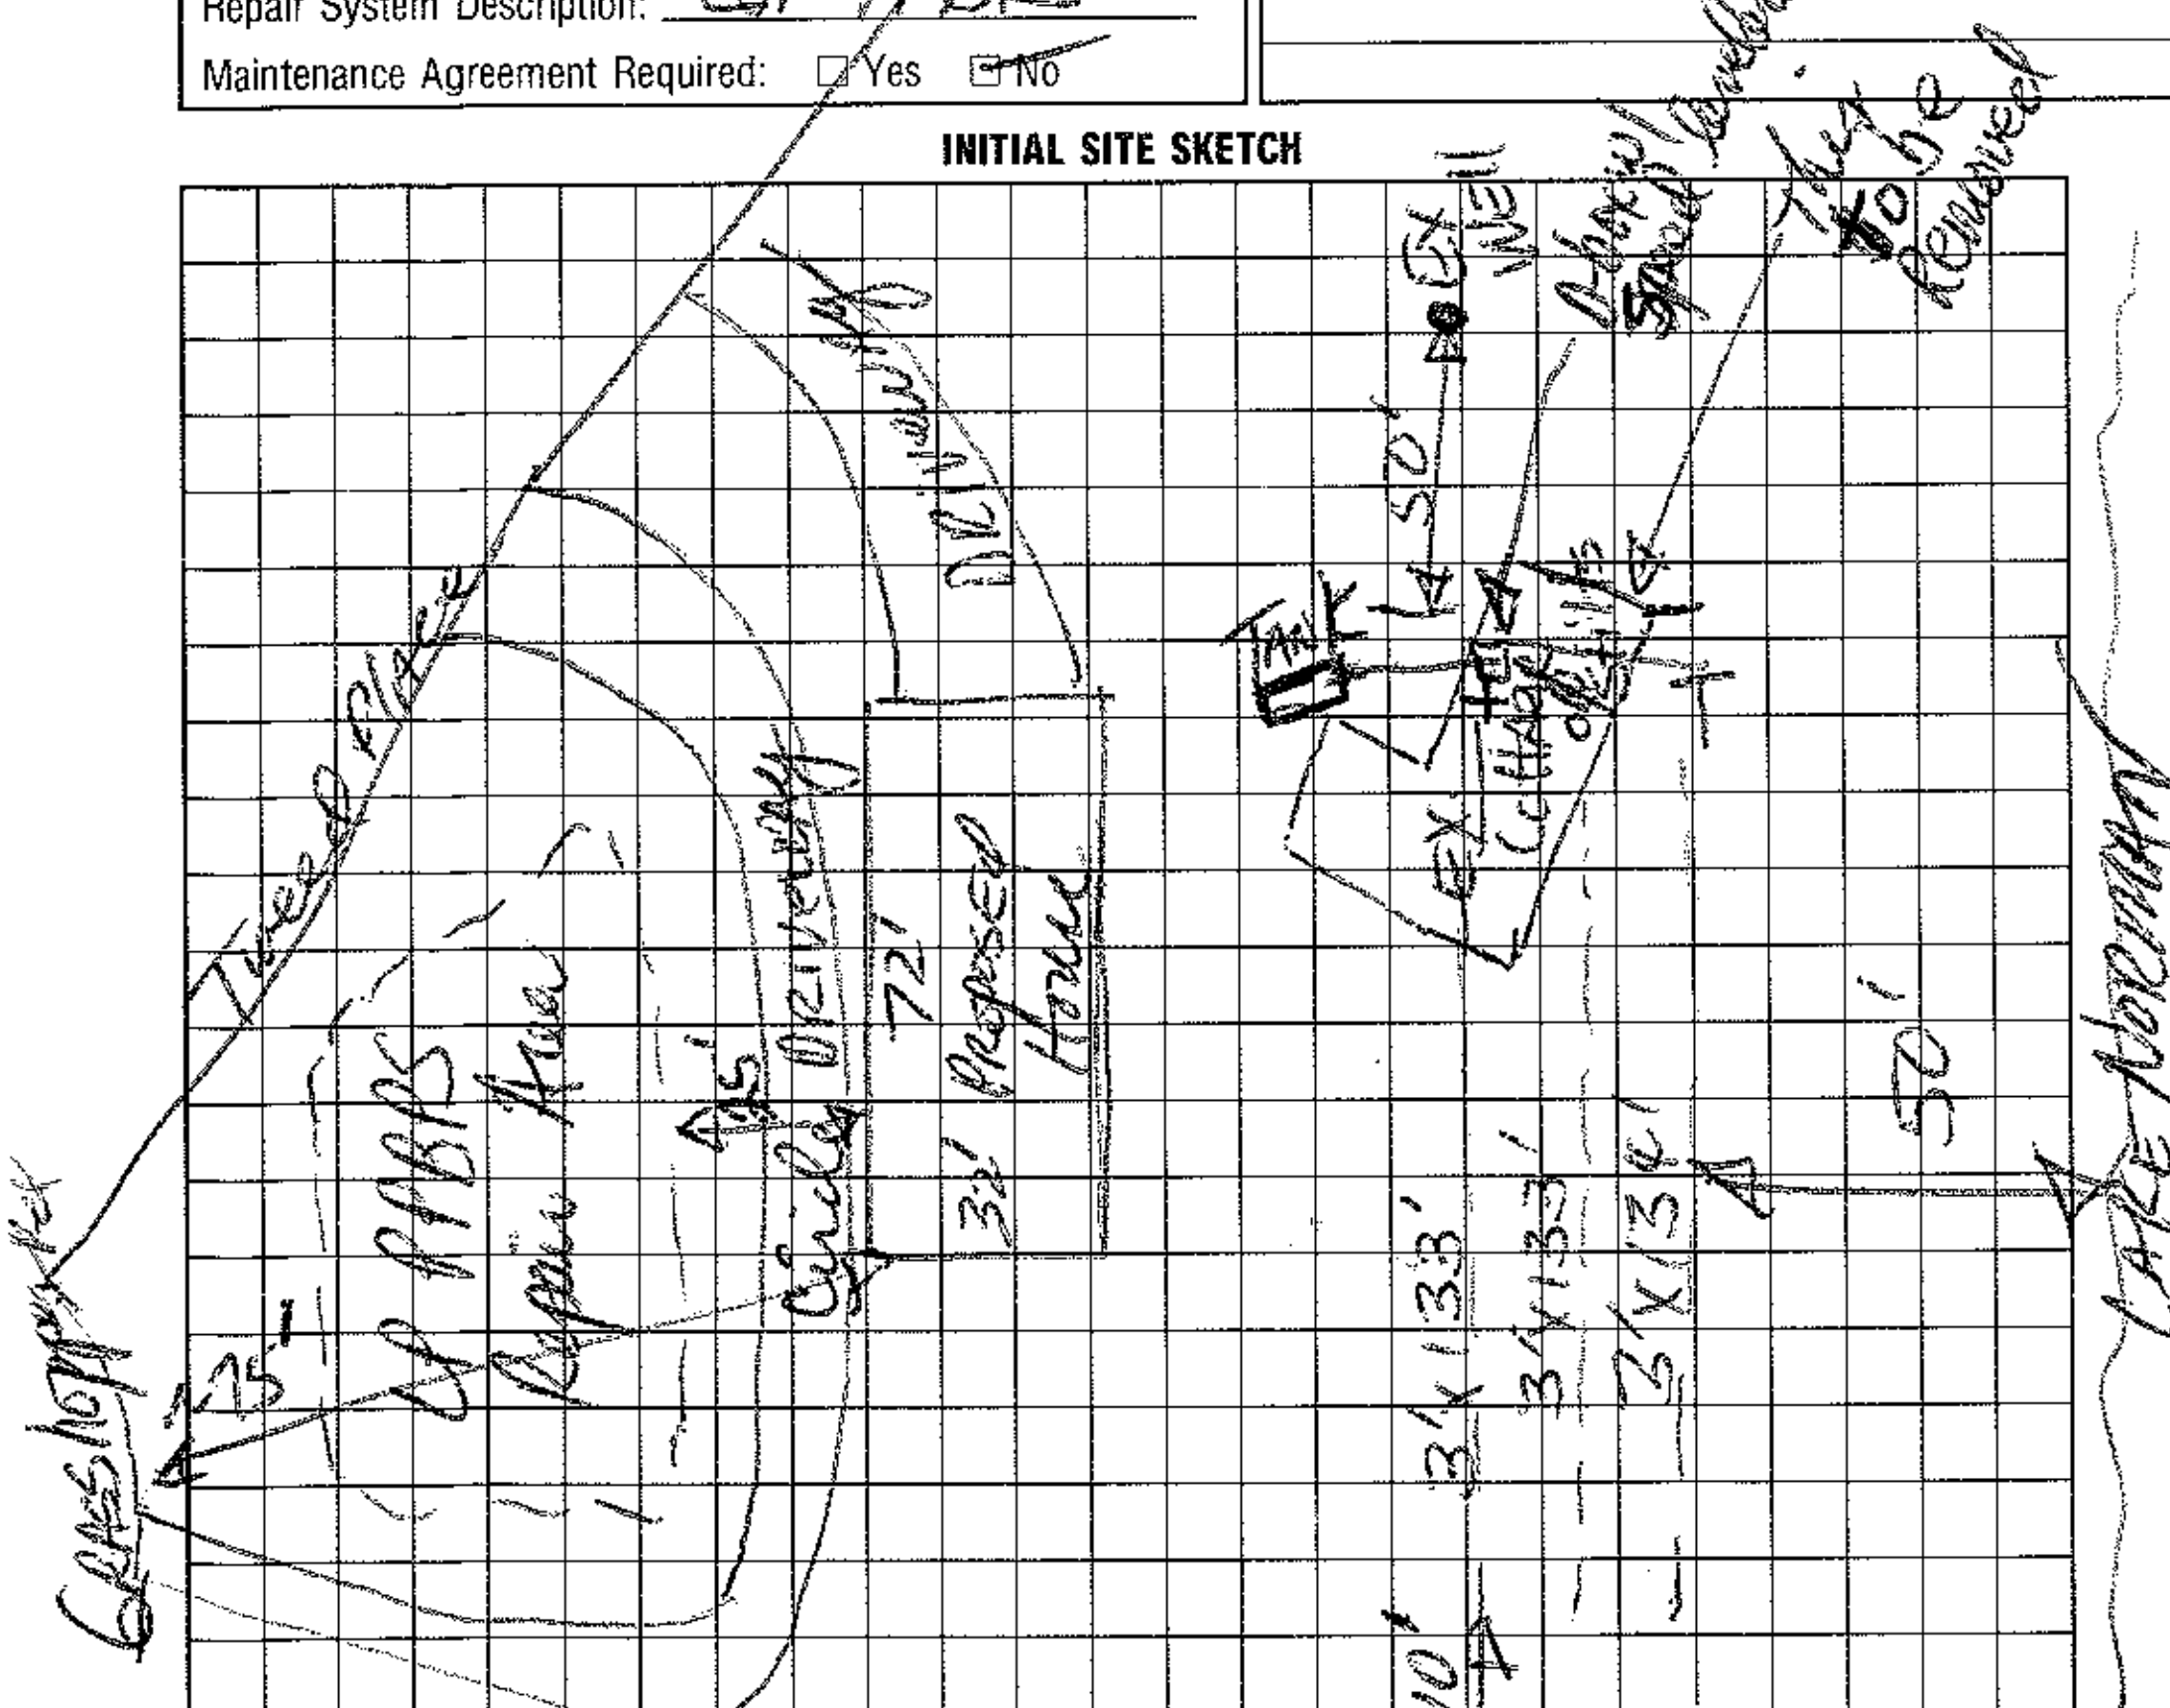

AS BUILT SKETCH

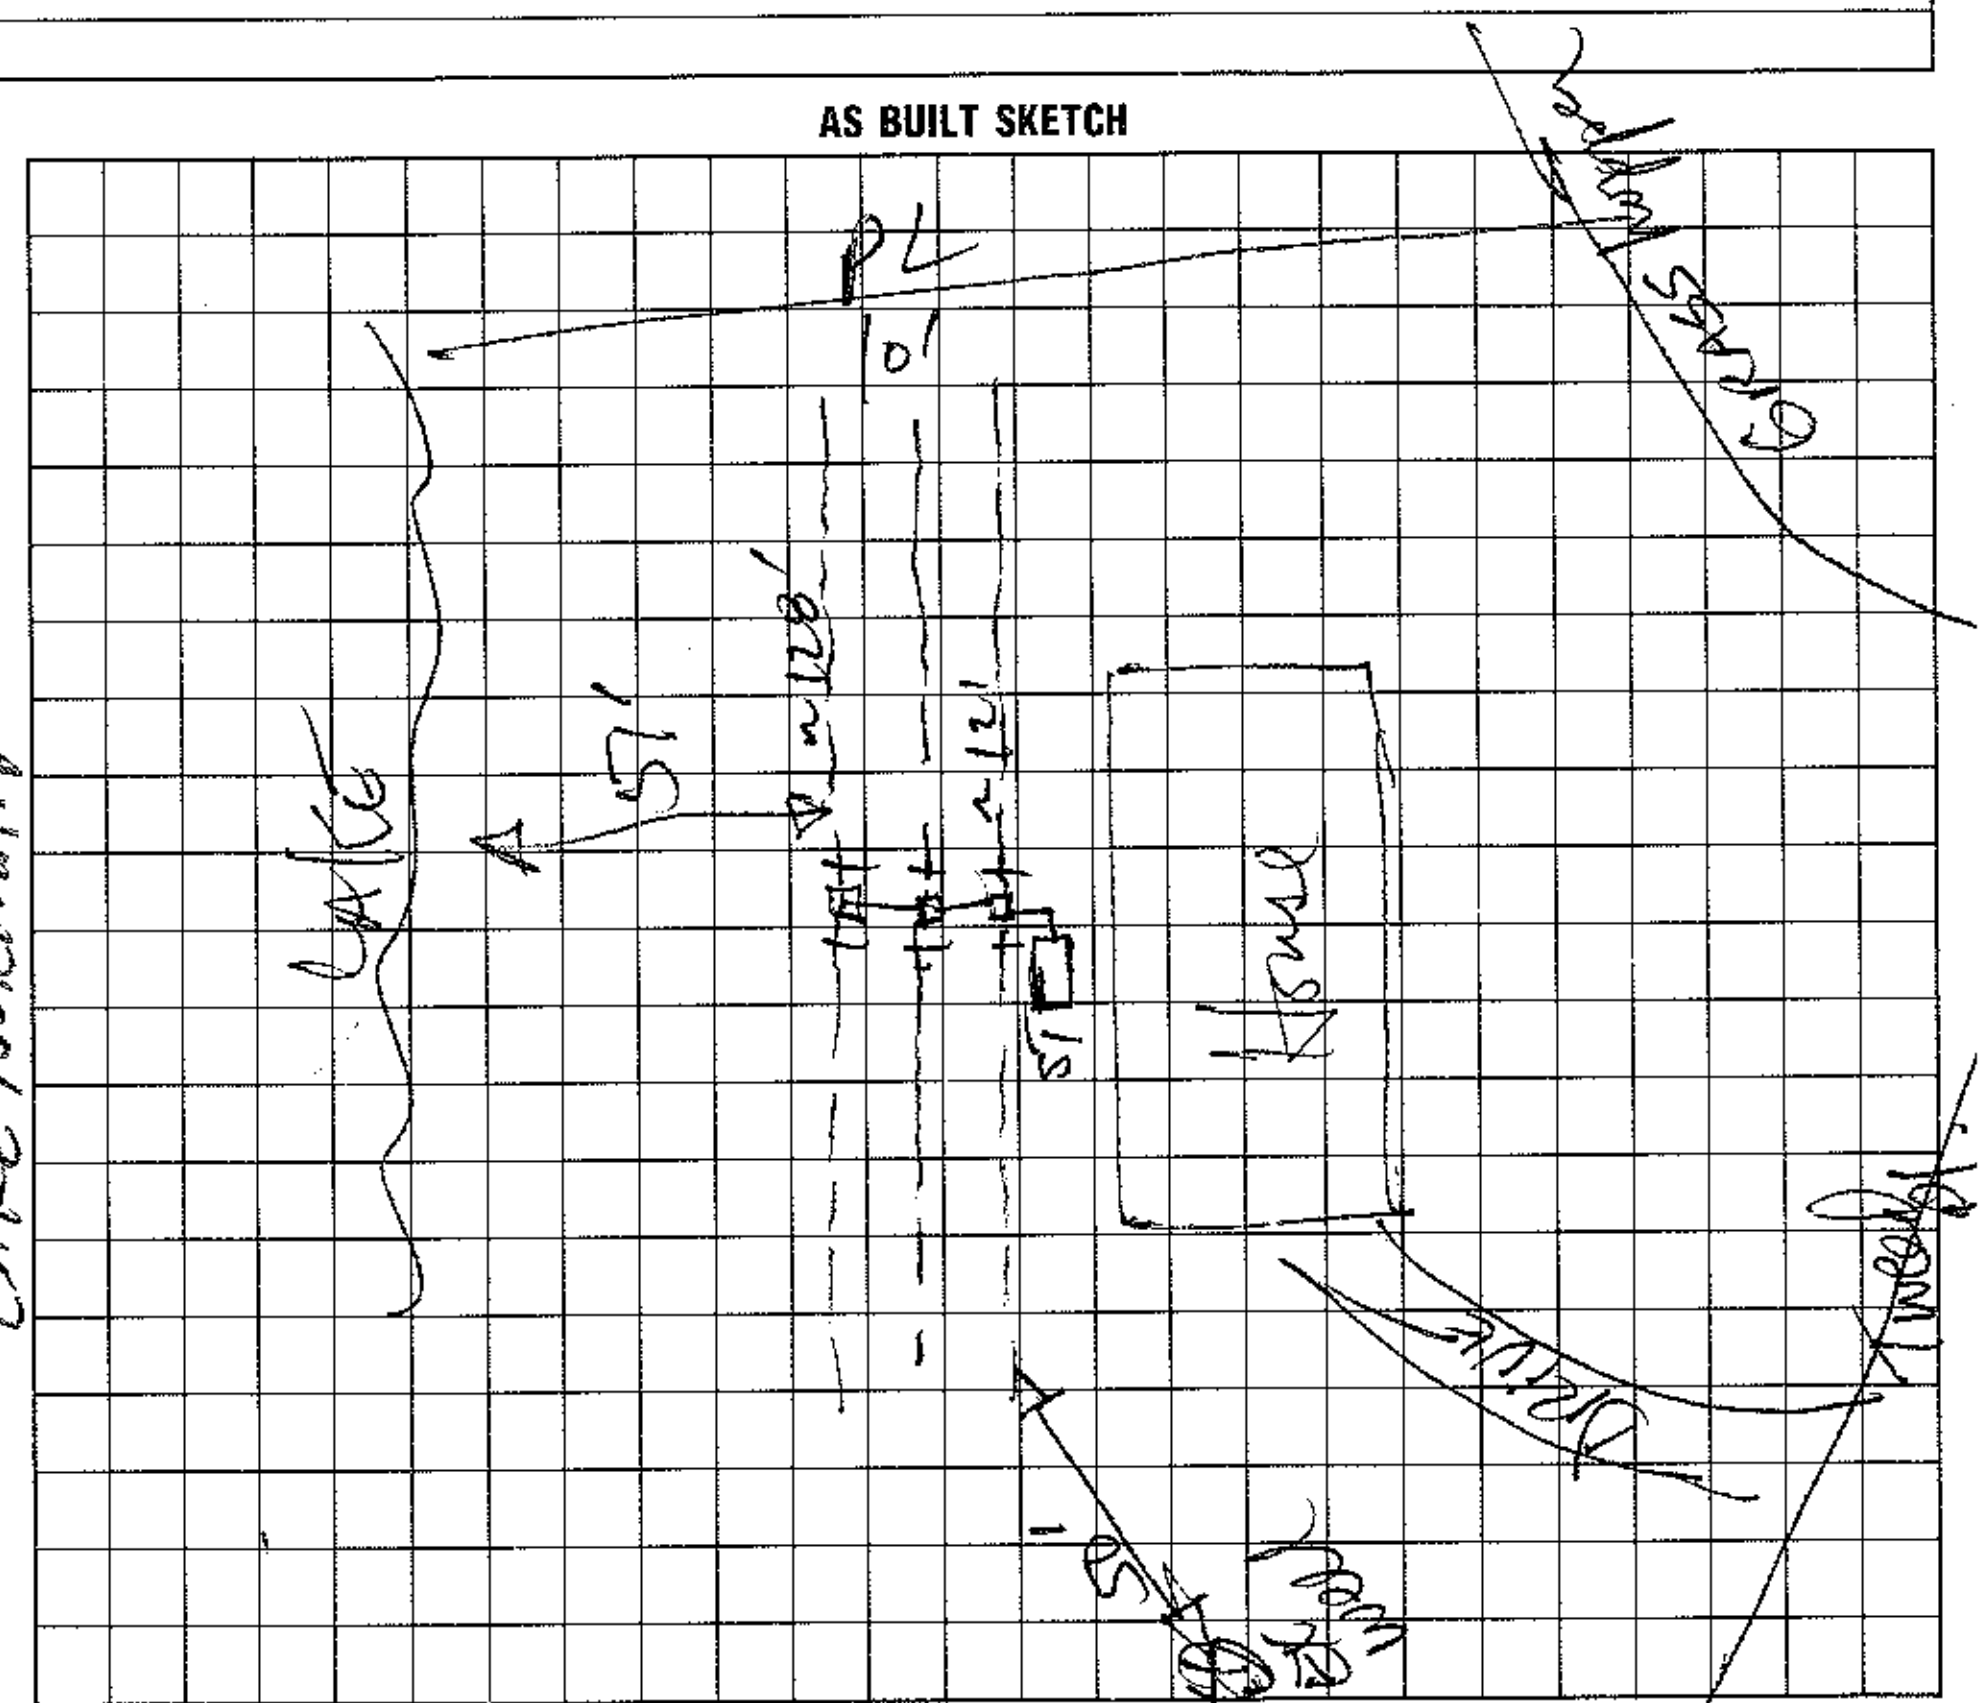

I understand that this permit can be suspended or revoked if any false information is supplied toward securing the permit/any unauthorized changes are made to the site/any unauthorized changes are made in the installation of the system. Improvement Permit is valid for 60 months from date of issuance.

Signed: Bob Stilp

Improvement Permit by: David R Hinson, RS date 9/28/93

Existing System Inspection by: ______ date ______

Installed by: Danny Whitaker / Davie Co.

Certificate of Completion by: ______ date ______

Operation Permit by: David R Hinson, RS date 2/18/97

HEALTH DEPT. COPY: WHITE INSPECTION COPY (FINAL): GREEN OWNER COPY (FINAL): YELLOW INSPECTION COPY (INITIAL): PINK OWNER COPY (INITIAL): GOLD