IREDELL COUNTY HEALTH DEPARTMENT

STATESVILLE 704-878-5305 MOORESVILLE 704-664-5281

IMPROVEMENT PERMIT / AUTHORIZATION TO CONSTRUCT / OPERATION PERMIT / EXISTING SYSTEM INSPECTION

PERMIT # 173671 PIN # 4627659893 DATE 7-19-2012

OWNER or APPLICANT Tommy Sawyer PHONE: Business 704 651 0861 Home: 704 663-5777

OWNER or APPLICANT ADDRESS 149 Hogan Ln Mooresville, NC

LOCATION / DIRECTIONS Hwy 150 West TC Paradise Peninsula TR Hogan Ln on Rt.

SUBDIVISION NA BLOCK / SECTION 10 LOT # 143 LOT AREA .72Ac DESIGN FLOW 360 gpd for Temp. L.T.A.R.

Septic Tank 1000 Gallons: STB Date

Pump Tank Gallons: P T Date

Pump Make Model Serial #

Nitrification Field No Fields 1 No Lines 2 Linear Feet 240 Ft

Trench Width 36" Max. Trench Bottom Depth Gravel Depth

☐ New System ☐ Repair ☐ Expansion System Type I II III IV V VI

System Description: EXIST. Gravity Conventional

Repair System Description:

Maintenance Agreement Required ☐ YES ☒ NO

☒ GRAVITY ☐ PRESSURE

☒ Residence No. Bedrooms 1

☐ Business No. Persons

☐ Other No. Employees

☐ Slab ☐ Crawl Space


☐ Basement w/plumbing ☐ Basement w/o plumbing

Water Supply: ☒ Private ☐ Public ☐ Community


Comments / Conditions: * Septic System designed for 3 Bedroom in 1984. Temp. MH will only have 1 Bedroom

Comments / Conditions: Existing Septic System "appears" to be Functioning Okay at time of inspection. *Must keep "Motorhome" at least 5Ft from Septic System

INITIAL SITE SKETCH

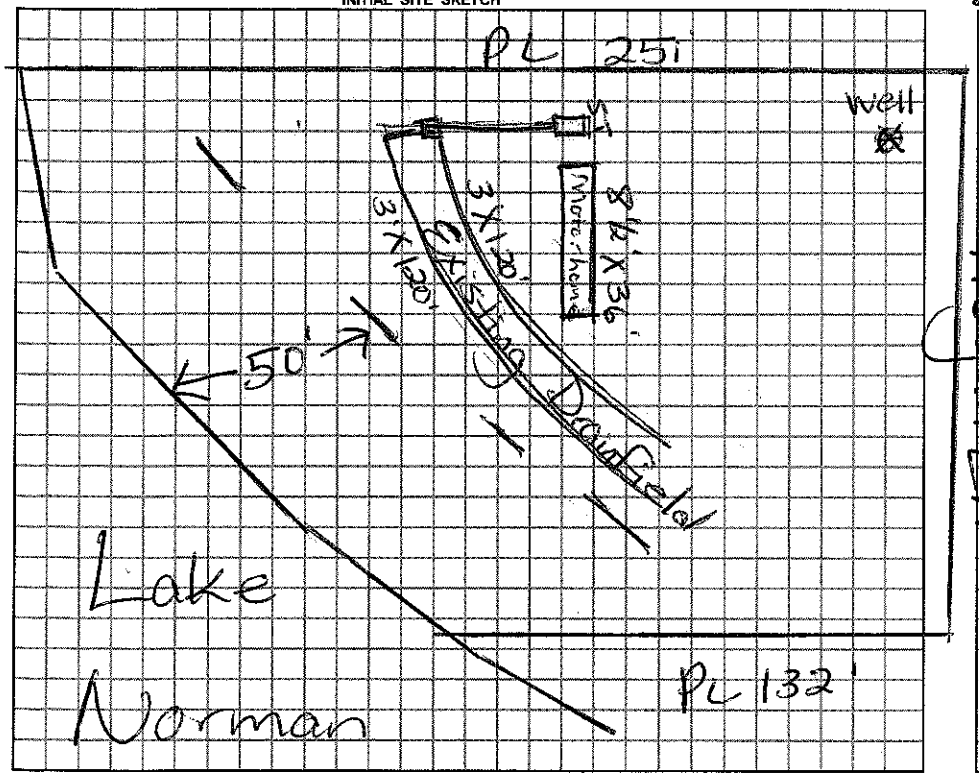

AS BUILT SKETCH

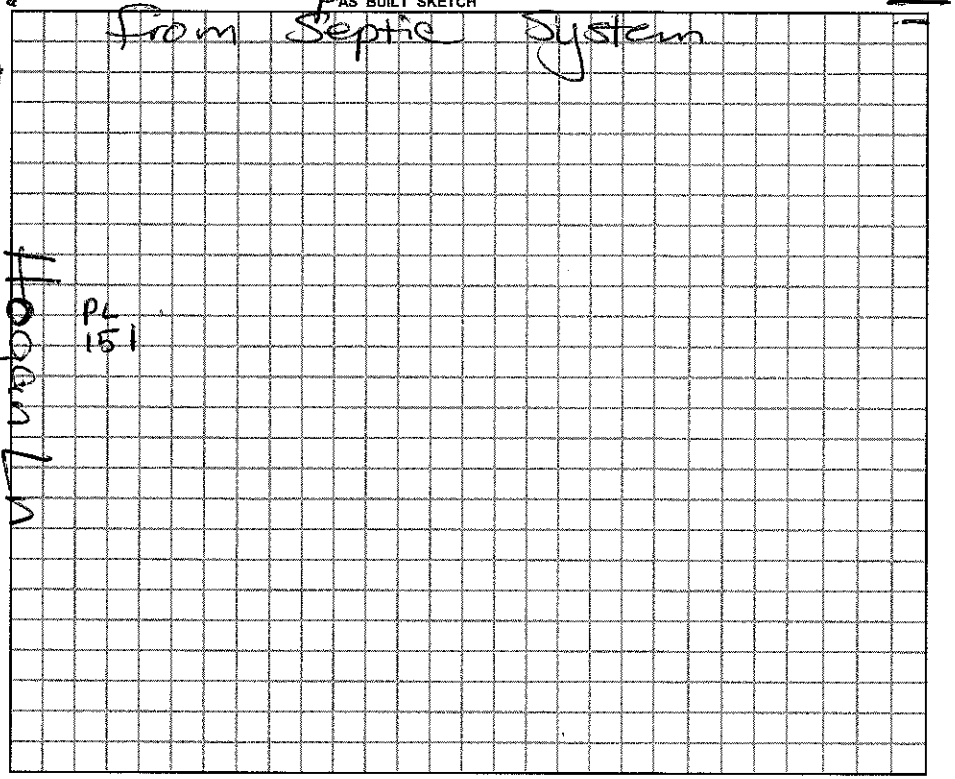

Permit can be suspended or revoked if any false information is supplied toward securing the permit / any unauthorized changes are made to the site / any unauthorized changes are made in the installation of the system.

☐ *IMPROVEMENT PERMIT w / plat valid without expiration.* ☐ *IMPROVEMENT PERMIT w / site plan valid for 60 mos.* ☐ *AUTHORIZATION TO CONSTRUCT valid for period equal to IMPROVEMENT PERMIT-not to exceed 60 mo.*

Owner / Applicant Signature: Tommy Sawyer Date 7-19-12

Improvement Permit by: Date

Authorzation to Construct by: Date

YOU SHOULD CONTACT A LOCATOR SERVICE PRIOR TO ANY EXCAVATION.

Installed by:

Operation Permit by: Date:

Existing System Inspected by: Marie Dotson BS Date: 7/19/12

WHITE COPY Environmental Health YELLOW COPY (Final) Owner / Applicant PINK COPY (Initial) Owner / Applicant