# IREDELL COUNTY HEALTH DEPARTMENT

Statesville Office (704) 878-5305 Mooresville Office (704) 660-3625

## IMPROVEMENT PERMIT / AUTHORIZATION TO CONSTRUCT / OPERATION PERMIT / EXISTING SYSTEM

PERMIT # 206335

PIN # 4627669193

APPLICANT: New Watt Homes, Inc for Investor APPLICANT ADDRESS: 720 Sheerers Rd Mooresville NC 28115

SITE ADDRESS: 140 Hogan Lane PHONE: (704) 663-2252 ALT. PHONE:

SITE DIRECTIONS: I-150W TL on Paradise Peninsula TL on Greenbay TR on Hogan Lane 6th lot on right

SUBDIVISION: CLT SECTION: 10 LOT # 145 LOT AREA: .710 ac DESIGN FLOW: 360 L.T.A.R.: .35

Septic Tank existing 1000 (gal) STB Date

Pump Tank existing 1000 (gal) PT Date

Pump Make Model Serial #

# Nitrification Fields # Lines Linear Ft:

Trench Width Max. Trench Bottom Depth Gravel Depth

☐ New System ☐ Repair ☐ Expansion System Type: I II III IV V VI

System Description: 5 lines 35' ea panel block w/ pressure manifold

Repair System Description: 100% repair area exempt

Maintenance Agreement Required: ☐ YES ☑ NO

☐ GRAVITY ☑ PRESSURE

☑ Residence ☐ Business ☐ Other ☐ Slab ☐ Basement w/plumbing


No. Bedrooms 3 No. Persons No. Employees

☑ Crawl Space ☐ Basement w/o plumbing


Water Supply: ☑ Private ☐ Public ☐ Community

Comments / Conditions: Previous recording date 5/9/77. Existing system and probable repair area are under gravel drive and parking area. Proposed Garage meets min setbacks from septic system and well. Existing system inspection for garage addition only. No increase in bedrooms or daily wastefl or change of use.

INITIAL SITE SKETCH

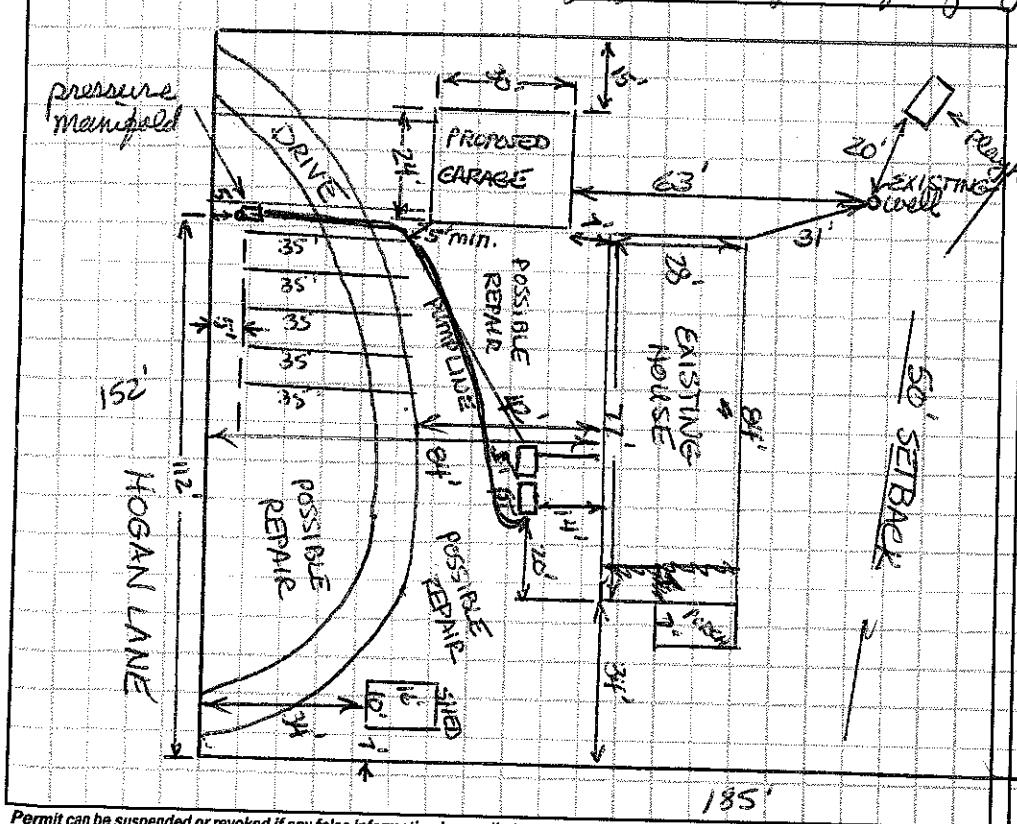


AS BUILT SKETCH

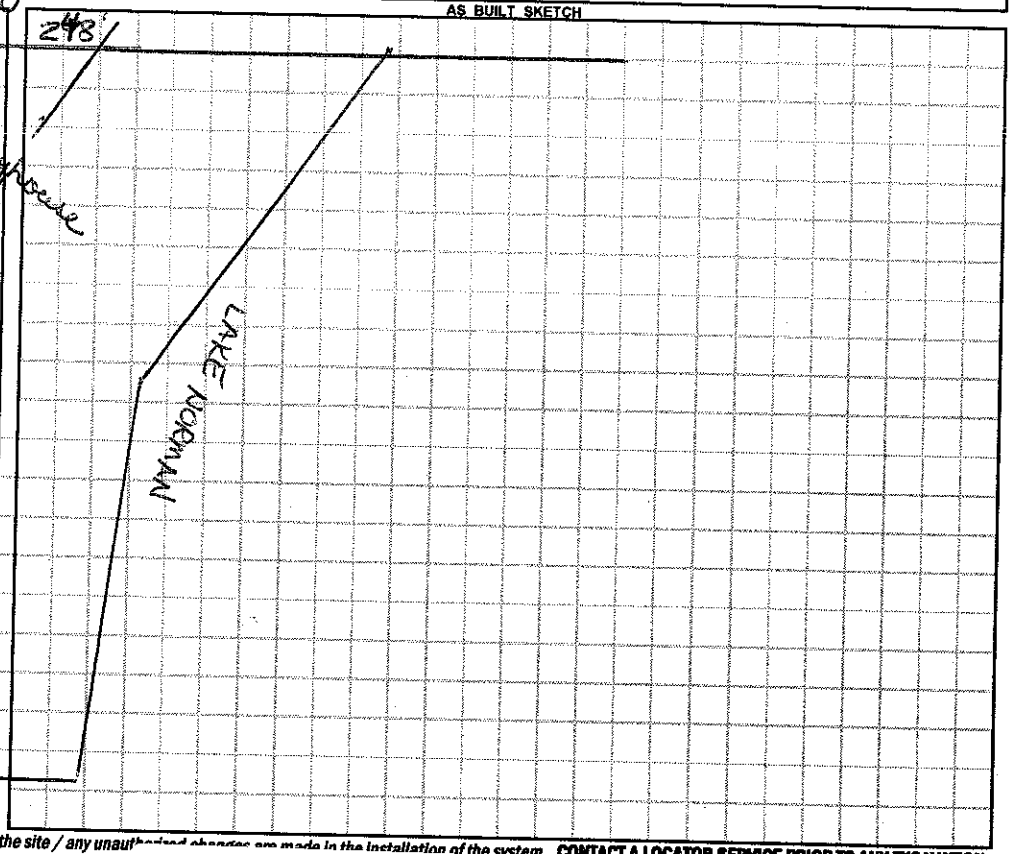


Permit can be suspended or revoked if any false information is supplied toward securing the permit / any unauthorized changes are made to the site / any unauthorized changes are made in the installation of the system. CONTACT A LOCATOR SERVICE PRIOR TO ANY EXCAVATION

☐ IMPROVEMENT PERMIT with plat valid without expiration. ☐ IMPROVEMENT PERMIT with site plan valid for 60 mos.

Owner / Applicant Signature: Richard J Watt Date: 10/28/14

IMPROVEMENT PERMIT by: Date:

AUTHORIZATION TO CONSTRUCT by: Date:

Installed by:

OPERATION PE

Existing Syste

Location of the proposed detached garage addition does not appear to impact the existing on-site septic system or well. **NOTE:

Richard Jarvis REHS Date: 10/27/14

ICHD-Environmental Health Division

ceed 60 mo.

27/14

Health Dept. Copy - WHITE Applicant (Final Approval) - YELLOW Applicant (Conditional Approval) - Pink