150.00 Paid

IREDELL COUNTY HEALTH DEPARTMENT

STATESVILLE 704-878-5305 MOORESVILLE 704-664-5281

IMPROVEMENT PERMIT / AUTHORIZATION TO CONSTRUCT / OPERATION PERMIT / EXISTING SYSTEM INSPECTION

PERMIT# 131623 PIN# 4627674801 DATE 10-21-05

OWNER OR APPLICANT Todd & Kelly Diffrich PHONE: Business (704) 528-2486 Home (704) 517-2811

ADDRESS 116 Creeky Hollow Dr. Mooresville, NC

LOCATION Hwy 150 TL Paradise Peninsula go to end to Cul-de-sac on left

SUBDIVISION C L & T BLOCK / SECTION 10 LOT 192 LOT AREA .701 Acre SITE CLASS. PS DESIGN FLOW 360gpd L.T.A.R. .3

Use 1060g Plastic ST

Septic Tank: 1000 Gallons; STB 531 Date

Pump Tank: Gallons; PT Date

Pump Make: Model Serial No.

Nitrification Field: No Fields 1 Square Feet 400' Linear Feet 200'

No Lines 5 Trench Width 24"-36" Max Trench Bottom Depth 36"

☒ New System ☐ Repair ☐ Expansion System Type: I II III IV V VI

System Description: Gravity -- Panel Block

Repair System Description: Pump-LP-Panel Blk

Maintenance Agreement Required: ☐ Yes ☒ No Not Initially

Gravel Depth N/A ☒ Gravity ☐ Pressure

☒ House/Mod. Home ☐ Mobile Home ☐ Business ☐ Other

No. Bedrooms 3 No. Persons No. Employees

Water Supply: ☒ Individual ☐ Public ☐ Community


☐ Slab ☒ Crawl Space ☐ Basement w/plumbing ☐ Basement wo/plumbing

Comments/Conditions: ☒ Note: Very tight lot, must be careful of setbacks (Save room for future Pump tank.)

Comments/Conditions: ☒ Abandon "old well" prior to installation of Septic System. "Properly abandon" old ST & disconnect from Drainfield. Keep new Septic System out of old Septic System.

Scale 1:50

INITIAL SITE SKETCH

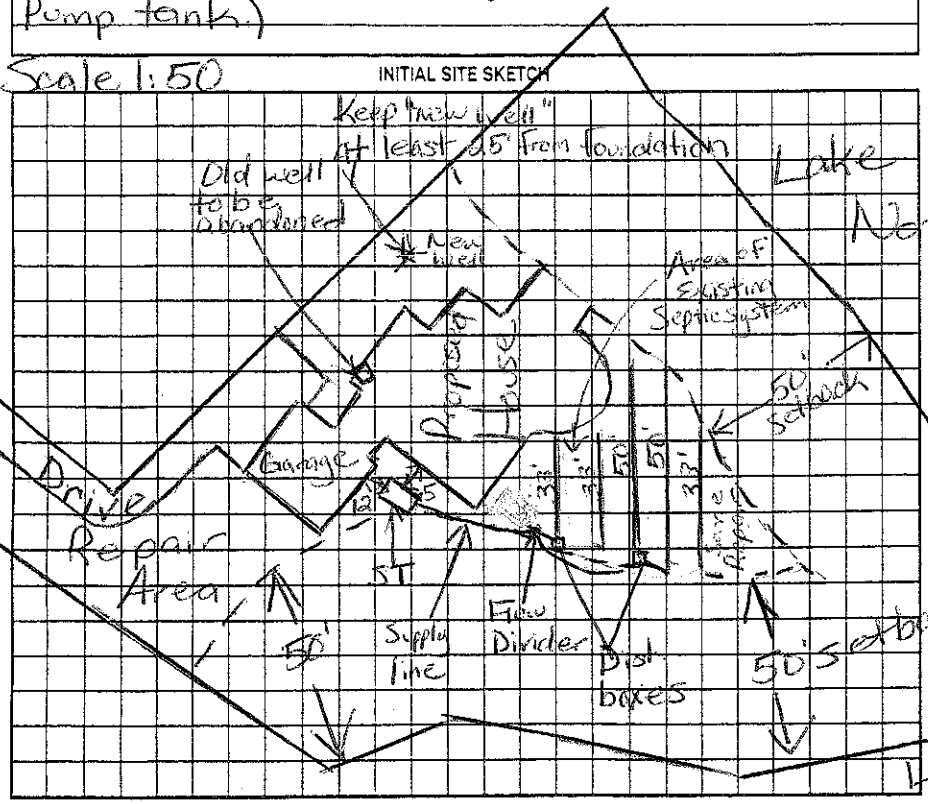

AS BUILT SKETCH

Lines checked 11/28/06 MD
ST ~ 12ft to Garage
~ 5ft to Deck
Installed Valve box over Flow Divider

Location of the proposed Pool addition does not appear to impact the existing on-site septic system.**NOTE: 15' To SEPTIC 15-A-006

REHS

Date: 6-6-11

ICHD-Environmental Health Division

Permit can be suspended or revoked if any false information is supplied toward securing the permit/any unauthorized changes are made to the site/any unauthorized changes are made in the installation of the system. Improvement Permit with plat valid without expiration ☐ Improvement Permit with site plan valid for sixty months ☐ Authorization to Construct is valid for a period equal to that of Improvement Permit – not to exceed sixty months.

Signed: [signature] date 10/24/05 Installed by: L.D. Rosemon Grading

Improvement Permit by: Maria H. Dotson RS date 10/21/05 Operation Permit by: Maria H. Dotson RS date 8/3/06

Authorization to Construct by: Maria H. Dotson RS date 10/21/05 Existing System Inspection by: date

HEALTH DEPT. COPY: WHITE OWNER COPY (FINAL): YELLOW OWNER COPY (INITIAL): PINK