ICHD - ENVIRONMENTAL HEALTH DIVISION

Statesville Office (704) 878-5305 | Mooresville Office (704) 660-3625 | PERMIT # AP OSWP 2023-13493

SEPTIC: IMPROVEMENT PERMIT / AUTHORIZATION TO CONSTRUCT / OPERATION PERMIT / EXISTING SYSTEM

PIN # 4627 -- 68 -- 1161

APPLICANT/OWNER: Jeanie Lentz | APPLICANT ADDRESS: 463 Lentz Rd, Statesville 28625

SITE ADDRESS: 240 Paradise Peninsula Rd, Mooresville 28117 | PHONE: ——— | ALT. PHONE 704-880-8903

SITE DIRECTIONS: River Hwy - (L) Paradise Peninsula - lot on (R) at end. | SAP CONTROLLED: ☐ YES ☐ NO


SUBDIVISION: CL&T | SECTION: 10 | LOT # 198 | LOT AREA: 0.7 | DESIGN FLOW: EX | L.T.A.R.: EX

Septic Tank	1000 (gal)	STB	760	Date	2-13-23	☐ New System ☑ Repair ☐ Expansion	System Type: I (II) III IV V VI	☑ Residence	No. Bedrooms EX
Pump Tank	(gal)	PT		Date		System Description: EX		☐ Business	No. Persons EX.
Pump Make		Model		Serial #		Repair System Description: EX.		☐ Other	No. Employees
# Nitrification Fields	EXISTING	# Lines		Linear Ft.		Maintenance Agreement Required: ☐ YES ☐ NO		☐ Slab	☐ Crawl Space
Trench Width		Trench Bottom Depth (Low side)		Gravel Depth		☐ GRAVITY ☐ PRESSURE		☑ Basement w/plumbing	☐ Basement w/o plumbing

Water Supply: ☑ Private ☐ Public ☐ Community

Comments / Conditions: 50' Buffer not marked at time of inspection, bed possibly in buffer. Install tank 15'+ off house.

INITIAL SITE SKETCH

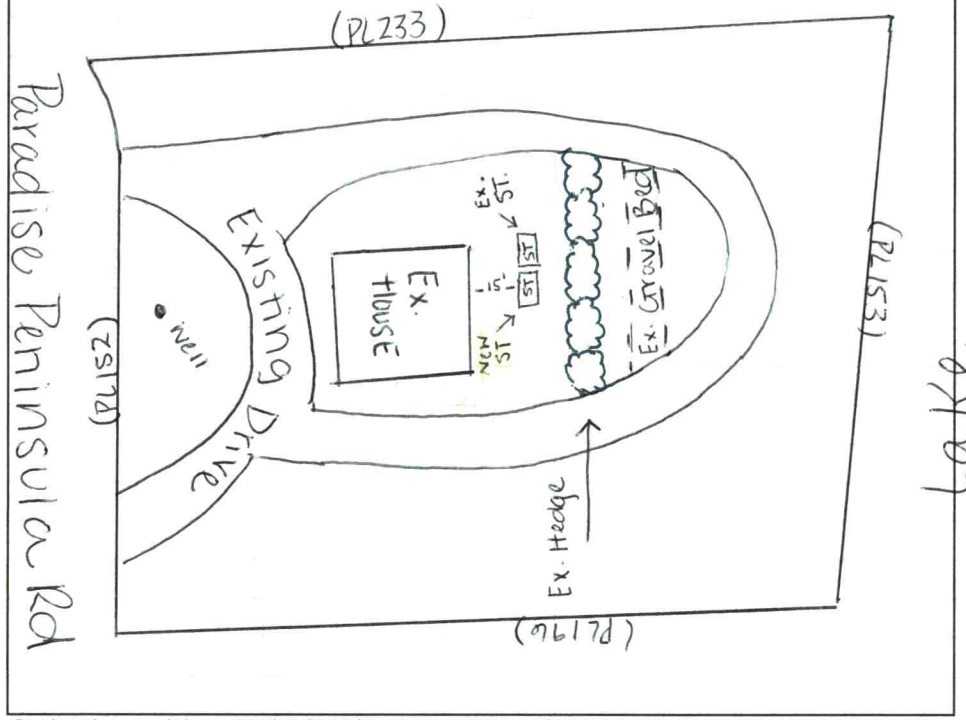

AS BUILT SKETCH

1" = 50'

FOR SEPTIC FINAL INSPECTION CALL: 704-664-3703 between 8am-9am
the day the inspection is needed. Be sure to speak with an inspector to confirm your time.

Permit can be suspended or revoked if any false information is supplied toward securing the permit / any unauthorized changes are made to the site / any unauthorized changes are made in the installation of the system. **CONTACT A LOCATOR SERVICE PRIOR TO ANY EXCAVATION**

☐ **IMPROVEMENT PERMIT** *with plat valid without expiration.* ☑ **IMPROVEMENT PERMIT** *with site plan valid for 60 mos.* ☑ **AUTHORIZATION TO CONSTRUCT** *valid for period equal to IMPROVEMENT PERMIT--not to exceed 60 mo.*

Owner / Applicant Signature: Online | Date: 1/11/23 | Installed by: Lentz

IMPROVEMENT PERMIT by: Sydney Holland | Date: 1/17/23 | OPERATION PERMIT by: Sydney Holland | Date: 5/11/23

AUTHORIZATION TO CONSTRUCT by: Sydney Holland | Date: 1/17/23 | Existing System Inspected by: | Date:

FOR SEPTIC FINAL INSPECTION: CALL 704-664-3703 between 8am-9am the day the inspection is needed.