IREDELL COUNTY HEALTH DEPARTMENT

IMPROVEMENT PERMIT / AUTHORIZATION TO CONSTRUCT / OPERATION PERMIT / EXISTING SYSTEM INSPECTION

STATESVILLE 704-878-5305 MOORESVILLE 704-664-5281

10,000

PERMIT# 120527 PIN# 4627683105

OWNER OR APPLICANT Frank DeFelice

ADDRESS 222 Paradise Pnsl PHONE: Business 704.664.2316 Home same DATE 8/20/08

LOCATION 150W, TL Paradise Peninsula, 1st end on rt.

SUBDIVISION CL&T BLOCK / SECTION 10 LOT 199 LOT AREA 0.83 acres SITE CLASS. P.S. DESIGN FLOW 480 gpd R. 0.3

Septic Tank: 1500 Gallons; STB 6-18-08 Date 6338

Pump Tank: 1500 Gallons; PT 477 Date 5-19-08

Pump Make: Liberty Model LEA7182 Serial No. 3/4 HP

Nitrification Field: No Fields 1 Square Feet 810 Linear Feet 270

No Lines 5 Trench Width 24" Max Trench Bottom Depth 36" Gravel Depth —

☒ New System ☐ Repair ☐ Expansion System Type: I II III ⓘ V VI

System Description: LP PPBPS

Repair System Description: LP PPBPS

Maintenance Agreement Required: ☒ Yes ☐ No

☒ House/Mod. Home ☐ Mobile Home ☒ Business ☐ Other

☐ Gravity ☒ Pressure ☐ Slab ☐ Crawl Space ☒ Baseme

Water Supply: ☒ Individual ☐ Shared ☐ Public ☐ Community


Comments/Conditions: * maintain all setbacks, Install on contour

Comments/Conditions: * Top line 15' from

* Valve box, 10' from side property

* sleeve ... over lines under drive

INITIAL SITE SKETCH

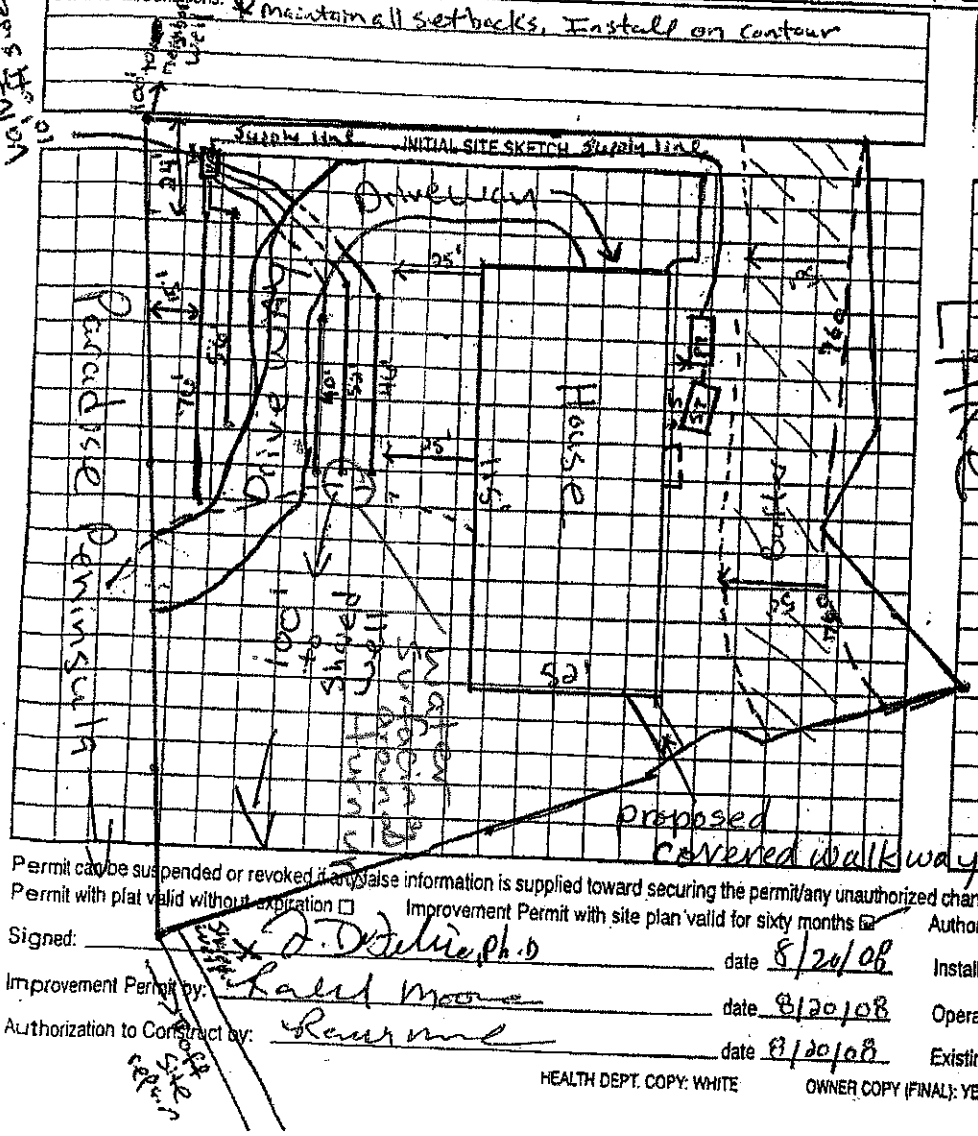

AS BUILT SKETCH

Final System Line Lengths

Top line – 76'

2nd line – 52' @ 6-08

3rd line – 48' 2e

4th line – 52' 46 Sytem Filter

bottom line – 46' 52

The proposed / existing covered walkway addition does not appear to impact the existing septic system.

**NOTE:

Andy Melville R.S.

Date: 2-26-13

ICHD-Environmental Health Division

Permit can be suspended or revoked if any false information is supplied toward securing the permit/any unauthorized changes are made to the site/any unauthorized changes are made in the installation of the system. Improvement Permit with plat valid without expiration ☐ Improvement Permit with site plan valid for sixty months ☒ Authorization to Construct is valid for a period equal to that of Improvement Permit – not to exceed sixty months.

Signed: A. DeFelice, Ph.D date 8/20/08

Improvement Permit by: Karl Moore date 8/20/08

Authorization to Construct by: Karl Moore date 8/20/08

Installed by: A-1

Operation Permit by: Karl Moore date 3/5/09

Existing System Inspection by: date

HEALTH DEPT. COPY: WHITE OWNER COPY (FINAL): YELLOW OWNER COPY (INITIAL): PINK

* BUILT COVERED WALKWAY IN 2013, BUT FAILED TO PULL BLDG PERMIT FOR IT. APPLIED FOR BLDG PERMIT ON 2/09/22-TH 2019