IREDELL COUNTY HEALTH DEPARTMENT

Statesville Office (704) 878-5305 | Mooresville Office (704) 660-3625 | PERMIT # Garage → 211532 / 210922 Existing Walkway

IMPROVEMENT PERMIT / AUTHORIZATION TO CONSTRUCT / OPERATION PERMIT / EXISTING SYSTEM

PIN # 4627684107

APPLICANT: Frank Defelice | APPLICANT ADDRESS: 232 Paradise Peninsula Mooresville, NC

SITE ADDRESS: 232 Paradise Peninsula | PHONE: | ALT. PHONE: 7046644-2316

SITE DIRECTIONS: Hwy 150 W. TL Paradise Peninsula on left near end

SUBDIVISION: CL&T | SECTION: 10 | LOT # 199-200 | LOT AREA: 1.236 | DESIGN FLOW: 480gpd | L.T.A.R.: .3


Septic Tank	1500 (gal)	STB		Date		☐ New System ☐ Repair ☐ Expansion	System Type: I II III (IV) V VI	☐ Residence	No. Bedrooms 4
Pump Tank	1500 (gal)	PT		Date		System Description: EXIST LPPPBPS		☐ Business	No. Persons
EXIST Pump Make		Model		Serial #		Repair System Description: LPPPBPS		☐ Other	No. Employees
# Nitrification Fields	1	# Lines	5	Linear Ft:	270	Maintenance Agreement Required: ☒ YES ☐ NO		☐ Slab	☐ Crawl Space
EXIST Trench Width	24"	Max. Trench Bottom Depth	36"	Gravel Depth	N/A	☐ GRAVITY ☒ PRESSURE		☐ Basement w/plumbing	☐ Basement w/o plumbing

Water Supply: ☐ Private ☐ Public ☐ Community


Comments / Conditions:

The proposed garage meets setbacks to dwell & Septic. The addition (garage) does not appear to impact the existing septic system

INITIAL SITE SKETCH

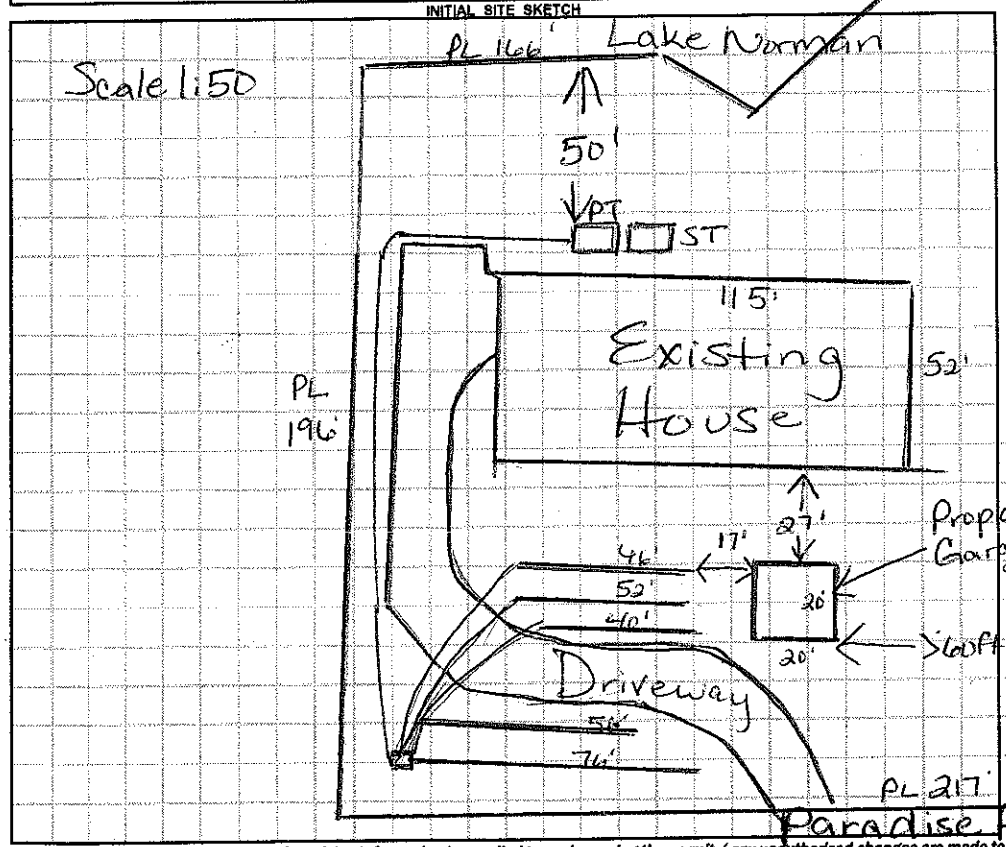

AS BUILT SKETCH

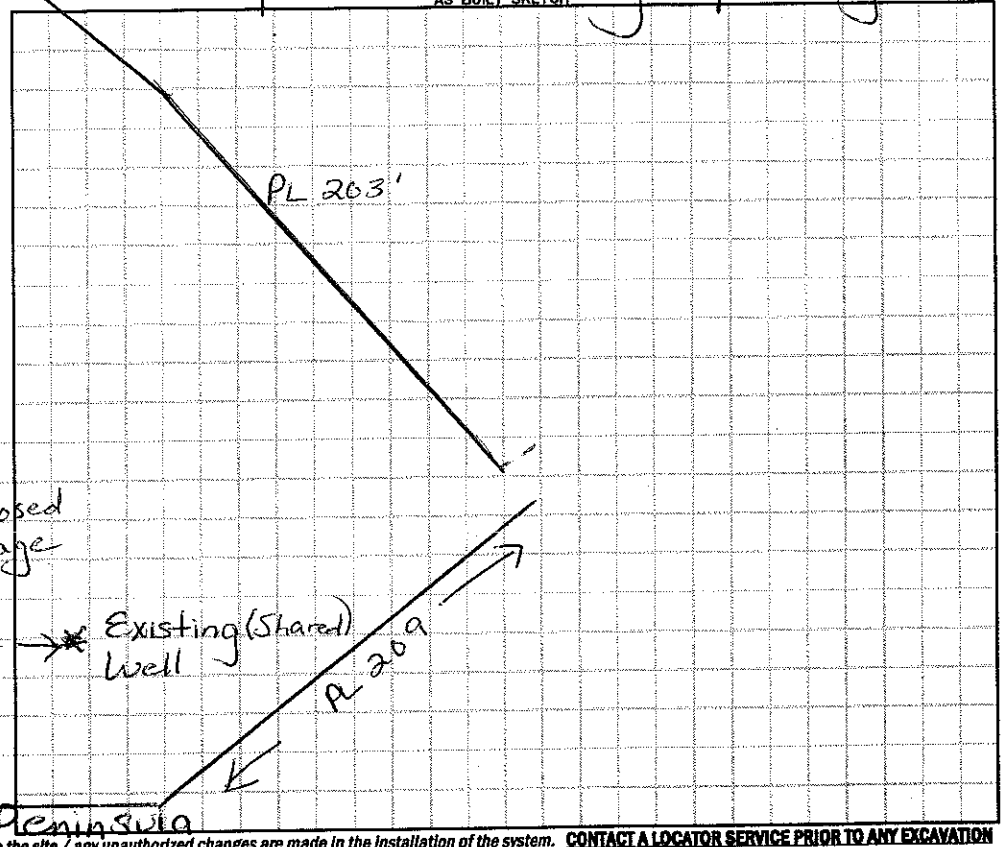

Permit can be suspended or revoked if any false information is supplied toward securing the permit / any unauthorized changes are made to the site / any unauthorized changes are made in the installation of the system. **CONTACT A LOCATOR SERVICE PRIOR TO ANY EXCAVATION**

☐ **IMPROVEMENT PERMIT** *with plat valid without expiration.* ☐ **IMPROVEMENT PERMIT** *with site plan valid for 60 mos.* ☐ **AUTHORIZATION TO CONSTRUCT** *valid for period equal to IMPROVEMENT PERMIT--not to exceed 60 mo.*

Owner / Applicant Signature: J. DiFelice PhD Date: 6/23/15

IMPROVEMENT PERMIT by: Date:

AUTHORIZATION TO CONSTRUCT by: Date:

Installed by:

OPERATION PERMIT by: Date:

Existing System Inspected by: Marina H. Dotson RS Date: 6/19/15

Health Dept. Copy - WHITE Applicant (Final Approval) - YELLOW Applicant (Conditional Approval) - PINK