IREDELL COUNTY HEALTH DEPARTMENT

Authorization to Construct

4627686002

STATESVILLE 704-878-5305 MOORESVILLE 704-664-5281

IMPROVEMENT PERMIT / CERTIFICATE OF COMPLETION / OPERATION PERMIT / EXISTING SYSTEM INSPECTION

PROPERTY DESCRIPTION NO. 25511 DATE 10/24/96 TAX MAP NO. 2L 6 A 190 Watershed: [X] Yes [ ] No

OWNER OR CONTRACTOR Grady Koon PHONE: Business Home 664-5062

ADDRESS 225 Paradise Pen. Mooresville, NC. 28115

LOCATION 150 W, Tl Paradise Pen Rd. ~ 3/4 mile on [L] # 225

SUBDIVISION CL+T BLOCK / SECTION 12 LOT 190 LOT AREA Existing SITE CLASS. DESIGN FLOW 360 L.T.A.R.

Septic Tank: 1000 Gallons; STB 794 Date 1/8/97
Pump Tank: Gallons; PT Date
Pump Make: Model Serial No.
Nitrification Field: No Fields N Square Feet Linear Feet
No Lines Trench Width Max Trench Bottom Depth Gravel Depth

[ ] New System [X] Repair System Type: I, [II], III, IV, V, VI
System Description: Replace Septic Tank
Repair System Description:
Maintenance Agreement Required: [ ] Yes [X] No

[ ] House/Mod. Home No. Bedrooms
[ ] Mobile Home No. Bathrooms
[ ] Business No. Employees
[ ] Other


[ ] Slab [ ] Crawl Space [ ] Basement w/plumbing [ ] Basement wo/plumbing

Water Supply: [ ] Individual [ ] Community [ ] Public

Comments: Replace & Relocate Septic Tank to 5' from addition LNE footings

Comments: Installed as Drawn.

INITIAL SITE SKETCH

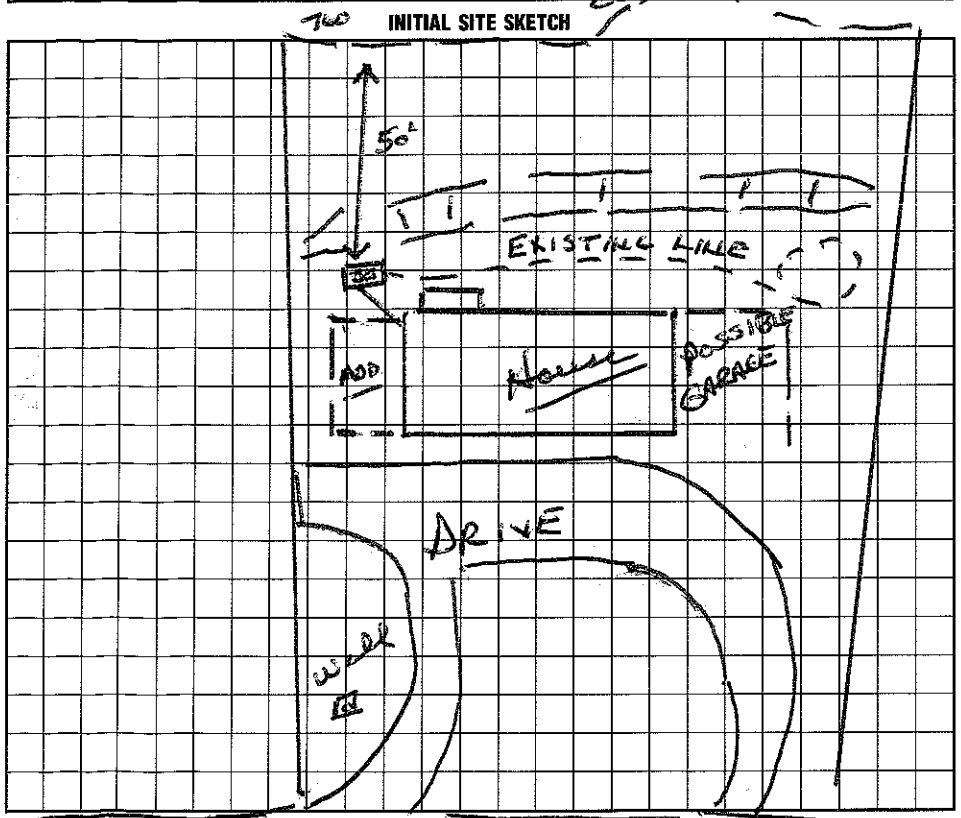

AS BUILT SKETCH

I understand that this permit can be suspended or revoked if any false information is supplied toward securing the permit/any unauthorized changes are made to the site/any unauthorized changes are made in the installation of the system.

Signed: G Koon

Improvement Permit by: Wesley Sparks RS. date 10/24/96

Existing System Inspection by: Wesley Sparks RS. date 10/24/96

Installed by: F J Enviro

Certificate of Completion by: Wesley Sparks RS date 4/3/97

Operation Permit by: Wesley Sparks RS date 4/3/97

HEALTH DEPT. COPY: WHITE INSPECTION COPY (FINAL): GREEN OWNER COPY (FINAL): YELLOW INSPECTION COPY (INITIAL): PINK OWNER COPY (INITIAL): GOLD