IREDELL COUNTY HEALTH DEPARTMENT

PLAN INVESTIGATION TO CONSTRUCT

STATESVILLE 704-878-5305 MOORESVILLE 704-664-5281

IMPROVEMENT PERMIT / ~~CERTIFICATE OF COMPLETION~~ / OPERATION PERMIT / EXISTING SYSTEM INSPECTION

PROPERTY DESCRIPTION NO. 065585 DATE 4/16/97 TAX MAP NO. 4627879912 Watershed: ☑ Yes ☐ No

OWNER OR CONTRACTOR CRAIG SHORE PHONE: Business _____ Home _____

ADDRESS 169 SUMMERSET LANE

LOCATION 150 W. TL PARADISE PENN. TR SUMMERSET - ON LEFT

SUBDIVISION CLT BLOCK / SECTION 10 LOT 1135 LOT AREA _____ SITE CLASS. RS DESIGN FLOW 360 GPD L.T.A.R. ENDSLEY

Septic Tank: _____ Gallons; STB _____ Date _____

Pump Tank: ENSPI NT Gallons _____ Date _____

Pump Make: _____ Model _____ Serial No. _____

Nitrification Field: No Fields ____ Square Feet _____ Linear Feet _____

No Lines _____ Trench Width _____ Max Trench Bottom Depth _____ Gravel Depth _____

☑ New System ☐ Repair System Type: I, II, III, IV, V, VI

System Description: PUMP PANEL

Repair System Description: SAME

Maintenance Agreement Required: ☑ Yes ☐ No

☑ House/Mod. Home No. Bedrooms 3

☐ Mobile Home No. Bathrooms 2

☐ Business No. Employees ____

☐ Other _____

☐ Slab ☐ Crawl Space ☐ Basement w/plumbing ☑ Basement wo/plumbing


Water Supply: ☑ Individual ☐ Community ☐ Public

Comments: SUPPLY LINE IS TO BE MOVED TO AVOID HOUSE PLACEMENT.

Comments: REPORT IN CRAIG SHORE - JULY - 1998

Supply line relocated away from foundation

INITIAL SITE SKETCH

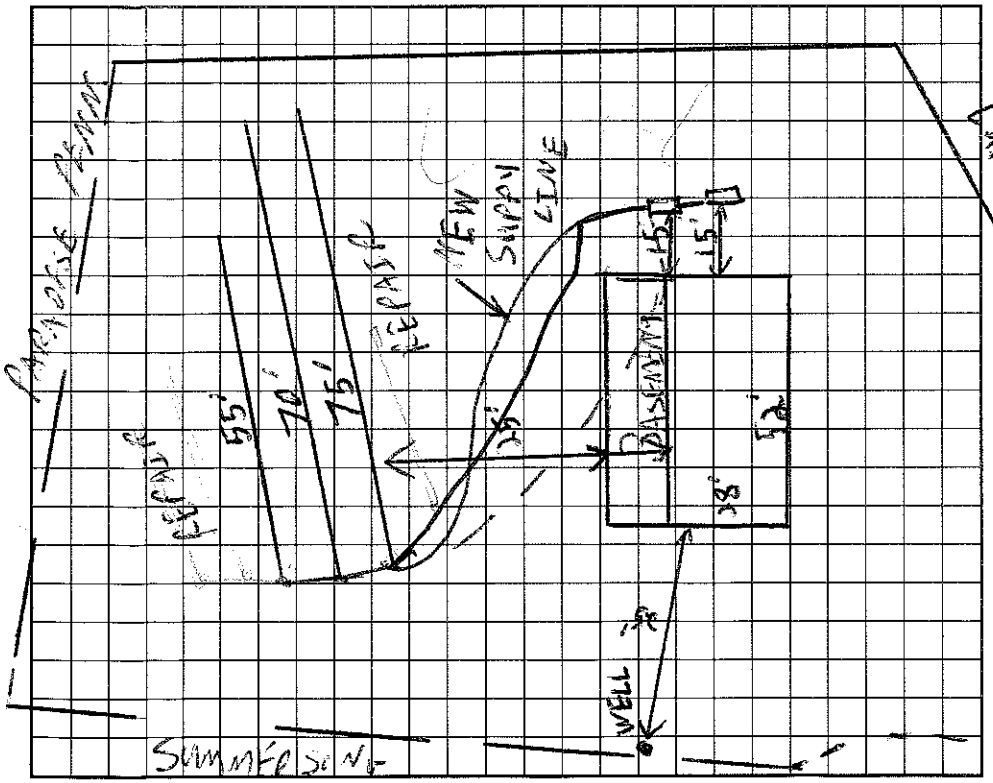

AS BUILT SKETCH

I understand that this permit can be suspended or revoked if any false information is supplied toward securing the permit/any unauthorized changes are made to the site/any unauthorized changes are made in the installation of the system. Improvement Permit is valid for 60 months from date of issuance.

Signed: Craig A Shore

Improvement Permit by: C. Ray Teem EHSR date 4/16/97

Existing System Inspection by: C. Ray Teem EHSR date 4/16/97

Installed by: Craig Shore - A1 Backhoe

Certificate of Completion by: Wesley Speaks RS date 12/12/97

Operation Permit by: Wesley Speaks R.S. date 12/12/97

HEALTH DEPT. COPY: WHITE INSPECTION COPY (FINAL): GREEN OWNER COPY (FINAL): YELLOW INSPECTION COPY (INITIAL): PINK OWNER COPY (INITIAL): GOLD