IREDELL COUNTY HEALTH DEPARTMENT

Statesville Phone TR 3-7271 Mooresville Phone NO 3-1271

PERMIT TO INSTALL SEPTIC TANK

Permit No. 150 Permit Date 10-11- 1971

Owner Ammons Address Mooresville

Installed By Olerson Address 11


Location of Property Sec. 9 Lot 34

Tank		Capacity		Length of Lines		Fixtures	
Block	( )	1000	( )	225'	( )	No. of Baths	(1)
Precast	(1)	1250	( )	250'	( )	Dishwasher	(No)
		1500	( )	Other 240		Garbage Grdr.	(No)
		Other				Other	

NOTIFY HEALTH DEPARTMENT AT LEAST EIGHT HOURS BEFORE TANK IS TO BE INSPECTED.

Final Inspection 10-11- 1971 Approved (✓) Disapproved ( )

Remarks

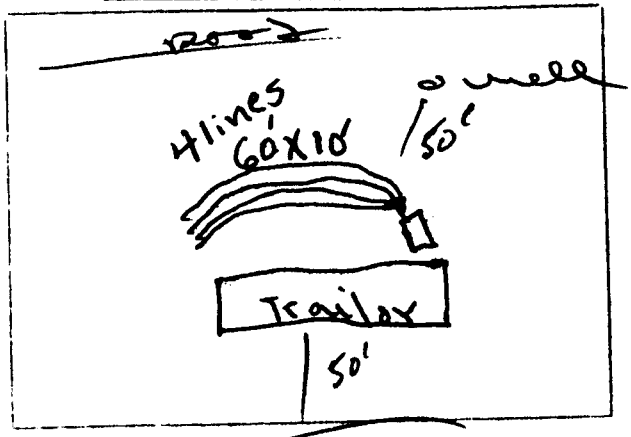

Sketch of Installation

J. C. Moore

Sanitarian