IREDELL COUNTY HEALTH DEPARTMENT

STATESVILLE 704-878-5305 MOORESVILLE 704-664-5281

IMPROVEMENT PERMIT / AUTHORIZATION TO CONSTRUCT / OPERATION PERMIT / EXISTING SYSTEM INSPECTION

PERMIT# 106290 PIN# 4627725650 DATE 5-15-2002

OWNER OR CONTRACTOR Jerome Eisele John PHONE: Business 704 417-5038 Home

ADDRESS 432 NW Cattlebuck Ct. Port St. Lucie FL 34983

LOCATION Brawley School Rd (R) Blume TC Beaten Path TR Honeysuckle Lane

SUBDIVISION Lk Norman BLOCK / SECTION 1 LOT 43 LOT AREA SITE CLASS. DESIGN FLOW L.T.A.R

Septic Tank: 1000 Gallons; STB Date

Pump Tank: Gallons; PT Date

Pump Make: Model Serial No.

Nitrification Field: No Fields 1 Square Feet Linear Feet 100'

No Lines 4@25' Trench Width Existing Max Trench Bottom Depth Gravel Depth

☒ New System ☐ Repair System Type: I, II, III, IV, V, VI

System Description: Existing Gravity-Panel

Repair System Description:

Maintenance Agreement Required: ☐ Yes ☒ No

☐ House/Mod. Home ☒ Mobile Home ☐ Business ☐ Other

No. Bedrooms 3 No. Bathrooms 2 No. Employees


☐ Slab ☒ Crawl Space ☐ Basement w/plumbing ☐ Basement wo/plumbing

Water Supply: ☒ Individual ☐ Public ☐ Community

Comments/Conditions: Existing Septic System appears to be functioning okay at time of inspection ☆ Not to Scale

Comments/Conditions: ☆ Keep new MH at least 5' from existing Septic System.

INITIAL SITE SKETCH

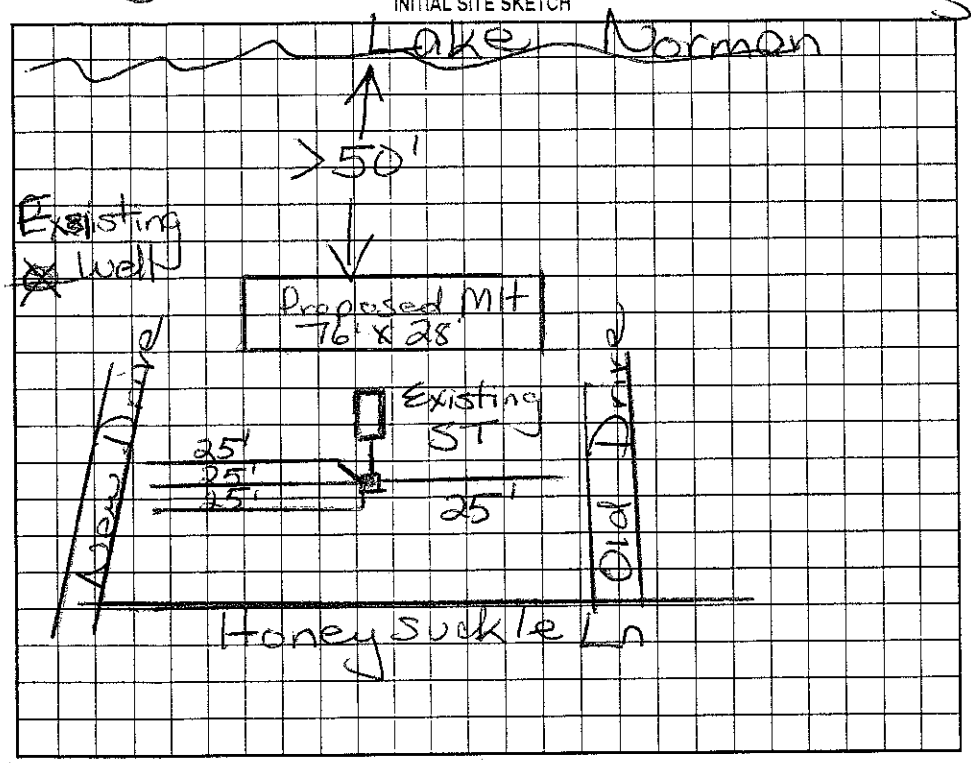

AS BUILT SKETCH

Orginally installed 1979

(Permit attached)

Permit can be suspended or revoked if any false information is supplied toward securing the permit/any unauthorized changes are made to the site/any unauthorized changes are made in the installation of the system. Improvement Permit with plat valid without expiration. Improvement Permit with site plan valid for sixty months. Authorization to Construct is valid for a period equal to that of Improvement Permit – not to exceed sixty months.

Signed: Jerome P. Eisele date 5/15/02 Installed by:

Improvement Permit by: Maria H. Dotson RS date 5/15/02 Operation Permit by: RS date

Authorization to Construct by: date Existing System Inspection by: Maria Dotson RS date 5/15/02

HEALTH DEPT. COPY: WHITE OWNER COPY (FINAL): YELLOW OWNER COPY (INITIAL): PINK