(2:30)

IREDELL COUNTY HEALTH DEPARTMENT

STATESVILLE 704-878-5305 MOORESVILLE 704-664-5281

IMPROVEMENT PERMIT / CERTIFICATE OF COMPLETION / OPERATION PERMIT / EXISTING SYSTEM INSPECTION

PROPERTY DESCRIPTION NO. D68896 DATE 9/4/97 TAX MAP NO. 4627761598 Watershed: ☒ Yes ☐ No

OWNER OR CONTRACTOR Earl Cannon PHONE: Business 864-1633 Home 864-4391 / 864-0565

ADDRESS 3101 Canterberry Dr Gastonia, NC 28054

LOCATION Hwy 150 West TR. Paradise Peninsula TL Greenbay TR Hogan on Rt.

SUBDIVISION Club T Sec 10 BLOCK / SECTION 10 LOT 148 LOT AREA _____ SITE CLASS. PS DESIGN FLOW 360gpd L.T.A.R. .3

Septic Tank: 1000 Gallons; STB 525 Date 7/27/97
Pump Tank: _____ Gallons; PT _____ Date _____
Pump Make: _____ Model _____ Serial No. _____
Nitrification Field: No Fields 1 Square Feet 1200 Linear Feet 400
No Lines 4 at 100' Trench Width 36" Max Trench Bottom Depth 36" Gravel Depth 12"

☒ New System ☐ Repair System Type: I (II) III, IV, V, VI
System Description: Grav. - Conventional
Repair System Description: _____
Maintenance Agreement Required: ☐ Yes ☒ No

☒ House/Mod. Home No. Bedrooms 3
☐ Mobile Home No. Bathrooms ____
☐ Business No. Employees ____
☐ Other _____
☐ Slab ☒ Crawl Space ☐ Basement w/plumbing ☐ Basement wo/plumbing


Water Supply:
☒ Individual
☐ Community
☐ Public

Comments: (Existing Septic Tank Needs to be properly abandoned)


Comments:

Scale ~1:40

INITIAL SITE SKETCH

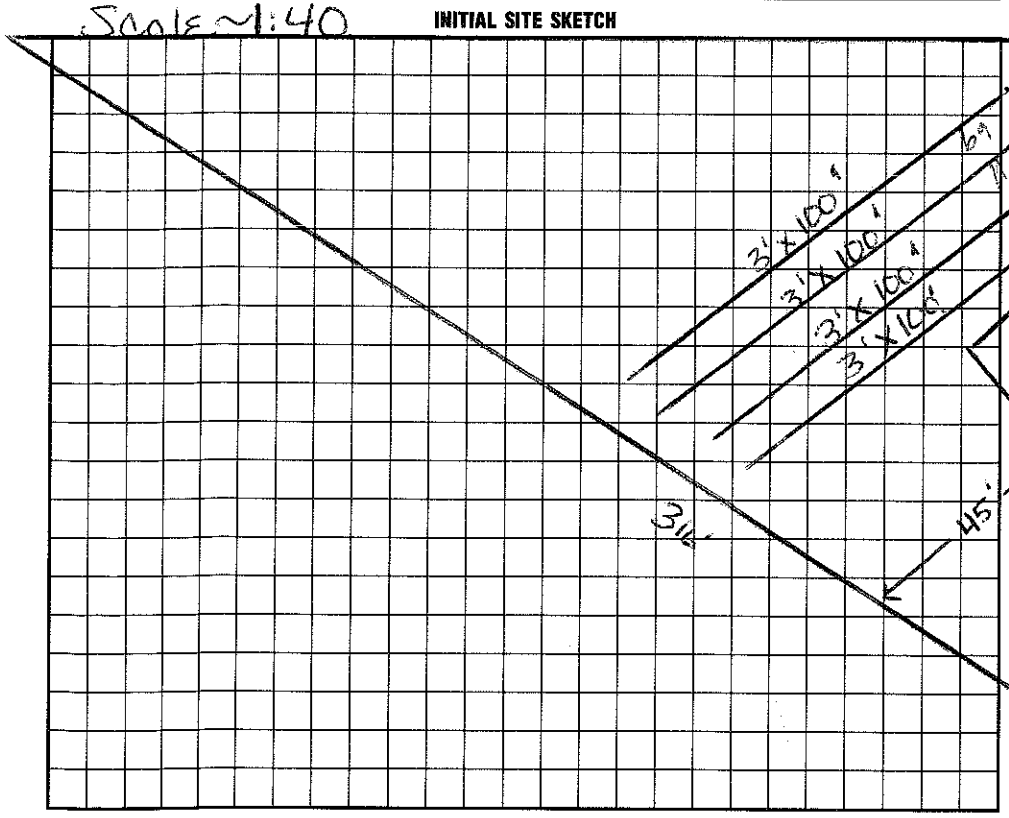

AS BUILT SKETCH

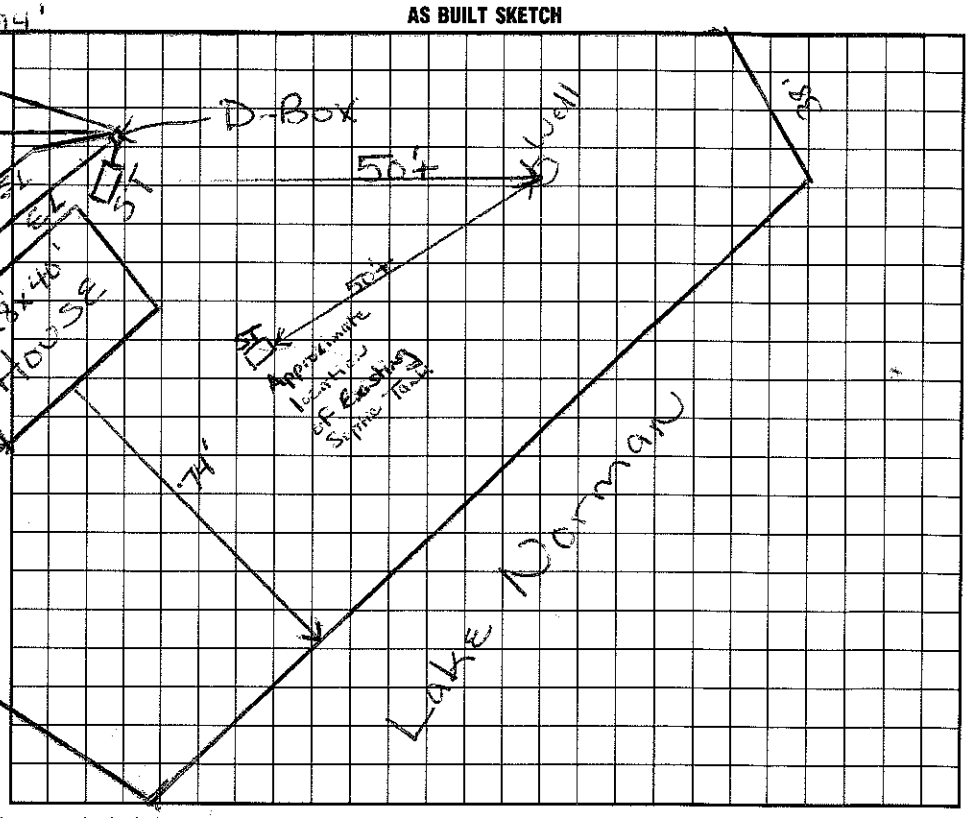

I understand that this permit can be suspended or revoked if any false information is supplied toward securing the permit/any unauthorized changes are made to the site/any unauthorized changes are made in the installation of the system. Improvement Permit is valid for 60 months from date of issuance.

Signed: Earl Cannon

Improvement Permit by: Maria H. Dotson date 9/5/97

Existing System Inspection by: Maria H. Dotson date 9/5/97

Installed by: Barry Simon

Certificate of Completion by: _____ date _____

Operation Permit by: C. _____ date 9/16/97

HEALTH DEPT. COPY: WHITE INSPECTION COPY (FINAL): GREEN OWNER COPY (FINAL): YELLOW INSPECTION COPY (INITIAL): PINK OWNER COPY (INITIAL): GOLD

Construct