IREDELL COUNTY HEALTH DEPARTMENT

STATESVILLE 704-878-5305 MOORESVILLE 704-664-5281

IMPROVEMENT PERMIT / AUTHORIZATION TO CONSTRUCT / OPERATION PERMIT / EXISTING SYSTEM INSPECTION

PERMIT# 084189 PIN# 4627 76 1851 DATE 11-15-99

OWNER OR CONTRACTOR Donald Eudy PHONE: Business (704) 545-4800 Home 528-4517/528-4516 John Putnam

ADDRESS 5616 Birchill Rd. Charlotte NC 28227

LOCATION Hwy 150 W. TL Paradise TL Greenbay TR Hagan TR Banty - 108 Banty

SUBDIVISION _____ BLOCK / SECTION _____ LOT _____ LOT AREA .73Acre SITE CLASS. _____ DESIGN FLOW 360gpd L.T.A.R. _____

Septic Tank: 1000 Gallons; STB 794 Date 9/18/99
Pump Tank: _____ Gallons; PT _____ Date _____
Pump Make: _____ Model _____ Serial No. _____
Nitrification Field: No Fields Existing Square Feet _____ Linear Feet _____
No Lines Existing Trench Width _____ Max Trench Bottom Depth _____ Gravel Depth _____

☒ New System ☐ Repair System Type: I, II, III, IV, V, VI
System Description: Gravity Conv.
Repair System Description: _____
Maintenance Agreement Required: ☐ Yes ☒ No


☐ House/Mod. Home No. Bedrooms 3
☒ Mobile Home No. Bathrooms 2
☐ Business No. Employees ____
☐ Other _____
☐ Slab ☒ Crawl Space ☐ Basement w/plumbing ☐ Basement wo/plumbing

Water Supply: ☒ Individual ☐ Public ☐ Community

Comments/Conditions: Install New Septic Tank (ST) & D-Box at least 5' from Home & 10' to PL & Connect to Existing Drainfield. Properly abandoned old Septic Tank.

Comments/Conditions: Replacing 3 Bedroom Singlewide with 3 Bedroom Doublewide MH.

INITIAL SITE SKETCH Not to Scale

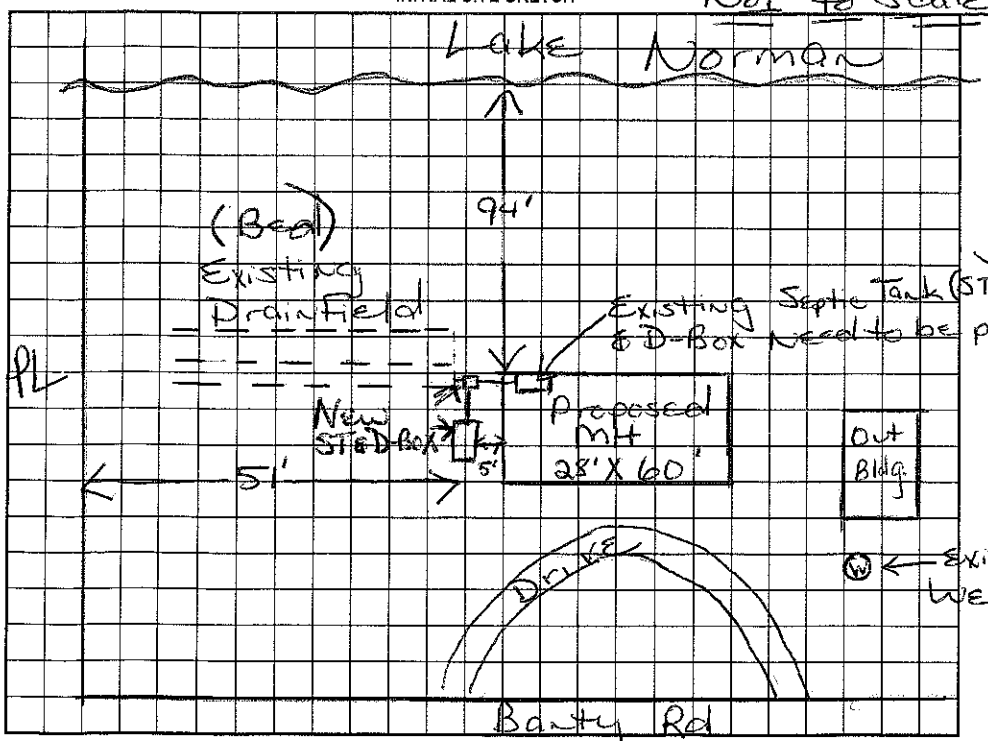

AS BUILT SKETCH

Permit can be suspended or revoked if any false information is supplied toward securing the permit/any unauthorized changes are made to the site/any unauthorized changes are made in the installation of the system. Improvement Permit with plat valid without expiration. Improvement Permit with site plan valid for sixty months. Authorization to Construct is valid for a period equal to that of Improvement Permit – not to exceed sixty months.

Signed: _____ date _____

Improvement Permit by: Maria H. Dotson, RS date 11/15/99

Authorization to Construct by: Maria H. Dotson, RS date 11/15/99

Installed by: Madison Bros.

Operation Permit by: Maria H. Dotson, RS date 11/30/99

Existing System Inspection by: Maria Dotson date 11/30/99

HEALTH DEPT. COPY: WHITE OWNER COPY (FINAL): YELLOW OWNER COPY (INITIAL): PINK