147781 1130

**IREDELL COUNTY HEALTH DEPARTMENT - *ENVIRONMENTAL HEALTH*** ☐ STATESVILLE OFFICE 704-878-5305 ☒ MOORESVILLE OFFICE 704-664-5281

**IMPROVEMENT PERMIT / AUTHORIZATION TO CONSTRUCT / OPERATION PERMIT / EXISTING SYSTEM INSPECTION**

PERMIT # 170608 PIN # 4627-76-4653 DATE 5-5-12

OWNER ROBERT & CECILIA BAKER APPLICANT: SAME PHONE: Home/Cell # 704-701-5104 Business #

SITE ADDRESS 111 HOGAN LN OWNER / APPLICANT ADDRESS SAME

SITE DIRECTIONS 150, PARADISE, GREEN BAY, HOGAN

SUBDIVISION CLET BLOCK / SECTION 10 LOT # 133 LOT AREA 1.08 AC DESIGN FLOW 480 L.T.A.R. .3

Septic Tank 1000 Gallons: STB 794 Date 10-28-11 ☒ New System ☐ Repair ☐ Expansion System Type I II (III) IV V VI

Pump Tank Gallons: P T Date System Description: 25%

Pump Make Model Serial # Repair System Description: BED + 25%

No. Nitrification Fields: 1 No. Lines 3 7 Linear Feet 400' Maintenance Agreement Required ☐ YES ☒ NO

Trench Width 36" Max. Trench Bottom Depth * 12" * Gravel Depth — ☒ GRAVITY ☐ PRESSURE

☒ Residence No. Bedrooms 4 Water Supply

☐ Business No. Persons ☒ Private

☐ Other No. Employees ☐ Public


☒ Slab ☒ Crawl Space ☐ Community

☐ Basement w/plumbing ☐ Basement w/o plumbing


Comments / Conditions ① BRING IN 6" OF TYPE I, II, III Soil Cover WELL

3/28/12 Maintained Shallow TB, 12" Used ADS36 for drainfield Line Lengths 55, 55, 60, 60, 65, 65, & 65 (Skipped over large tree)

INITIAL SITE SKETCH

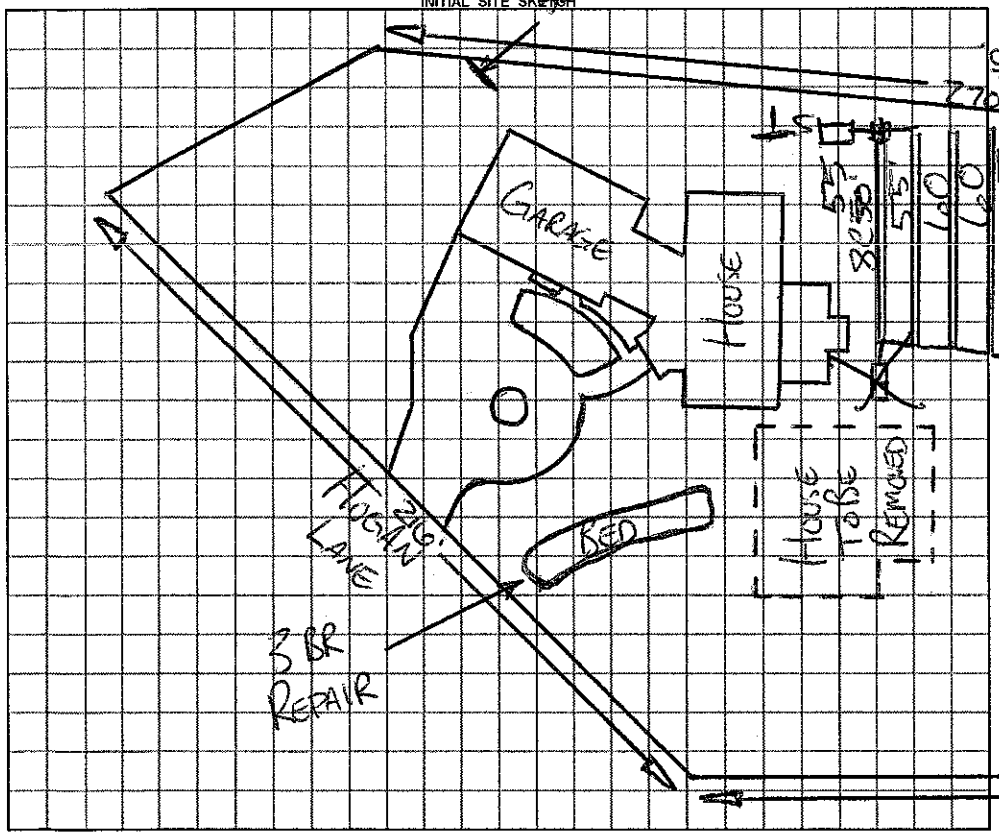


AS BUILT SKETCH

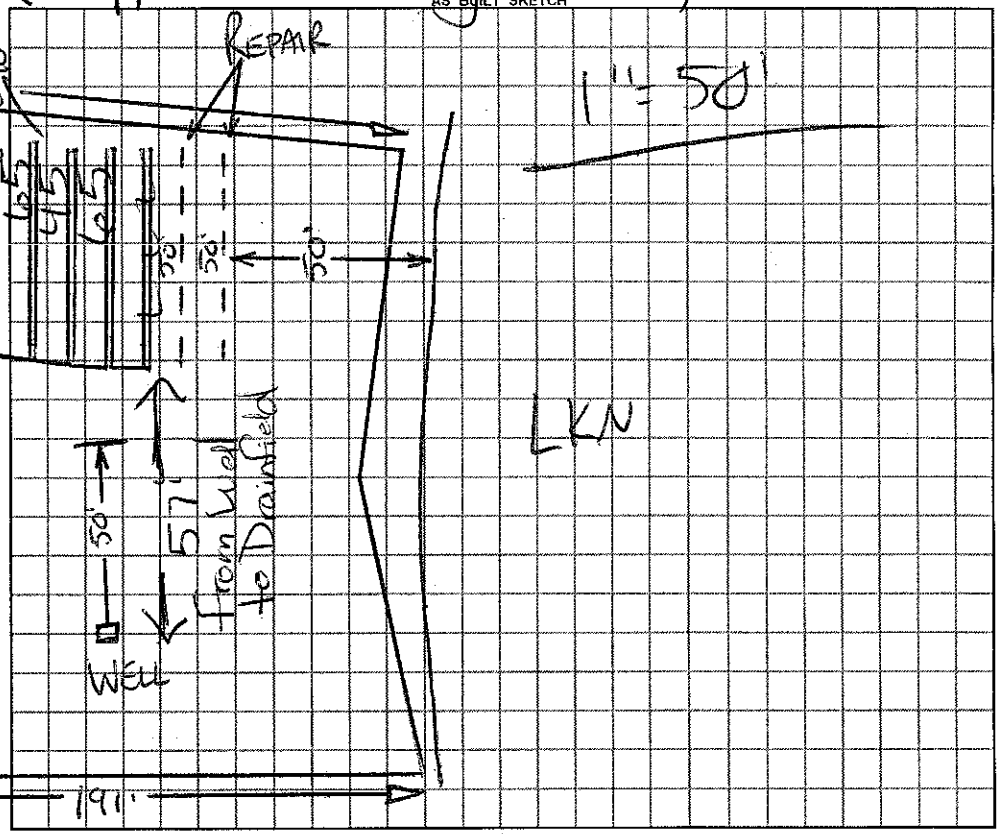


*Permit can be suspended or revoked if any false information is supplied toward securing the permit / any unauthorized changes are made to the site / any unauthorized changes are made in the installation of the system.*

☐ ***IMPROVEMENT PERMIT*** *with plat valid without expiration.* ☒ ***IMPROVEMENT PERMIT*** *with plat valid without expiration. site plan valid 60 mo.* ☒ ***AUTHORIZATION TO CONSTRUCT*** valid for period equal to IMPROVEMENT PERMIT--not to exceed 60 mo.

Owner / Applicant Signature: Date 3-7-12 Installed by: Richard Abercrombie RS

IMPROVEMENT PERMIT by: REHS Date 3-5-12 OPERATION PERMIT by: REHS Date 3/28/2012

AUTHORIZATION TO CONSTRUCT by: REHS Date 3-7-12 Existing System Inspected by: REHS Date

***YOU SHOULD CONTACT A LOCATOR SERVICE PRIOR TO ANY EXCAVATION***

White Copy -- Environmental Health YELLOW COPY (Final) Owner / Applicant PINK COPY (Initial) Owner / Applicant