IREDELL COUNTY HEALTH DEPARTMENT

STATESVILLE 704-878-5305 MOORESVILLE 704-664-5281

IMPROVEMENT PERMIT / AUTHORIZATION TO CONSTRUCT / OPERATION PERMIT / EXISTING SYSTEM INSPECTION

PERMIT# 113404 PIN# 4627-88-5496.018 4627-76-5948 DATE Sept 29, 03

OWNER OR CONTRACTOR Greenbay Forest LLC / Ray Short PHONE: Business Home

ADDRESS P.O. Box 3608, Mooresville, N.C. 28117

LOCATION 150 West TL Paradise Peninsula TL Greenbay on left across from Hogan Lane

SUBDIVISION Greenbay Forest BLOCK / SECTION LOT 18 LOT AREA 1.34Ac SITE CLASS PS DESIGN FLOW 480gpd L.T.A.R. .25-.3

Septic Tank: 1000 Gallons; STB 312 Date 7/19/04
Pump Tank: 1000 Gallons; PT 283 Date 7/20/04
Pump Make: Model Serial No.
Nitrification Field: No Fields 1 Square Feet 1440 Linear Feet 480
No Lines 4@120' Trench Width 36" Max Trench Bottom Depth 36" Gravel Depth NR

☑ New System ☐ Repair System Type: I, II, III, IV, V, VI
System Description: pm - 25% Reduction
Repair System Description: pm/ip 25-50% Reduction
Maintenance Agreement Required: ☐ Yes ☑ No

☐ House/Mod. Home No. Bedrooms 4/4
☐ Mobile Home No. Bathrooms
☐ Business No. Employees
☐ Other

☐ Slab ☑ Crawl Space ☐ Basement w/plumbing ☐ Basement wo/plumbing


Water Supply: ☑ Individual ☐ Public ☐ Community

Comments:/Conditions:
Reviewed Site plan & Building Plans 4/29/04


Comments:/Conditions:

1"=50'

INITIAL SITE SKETCH

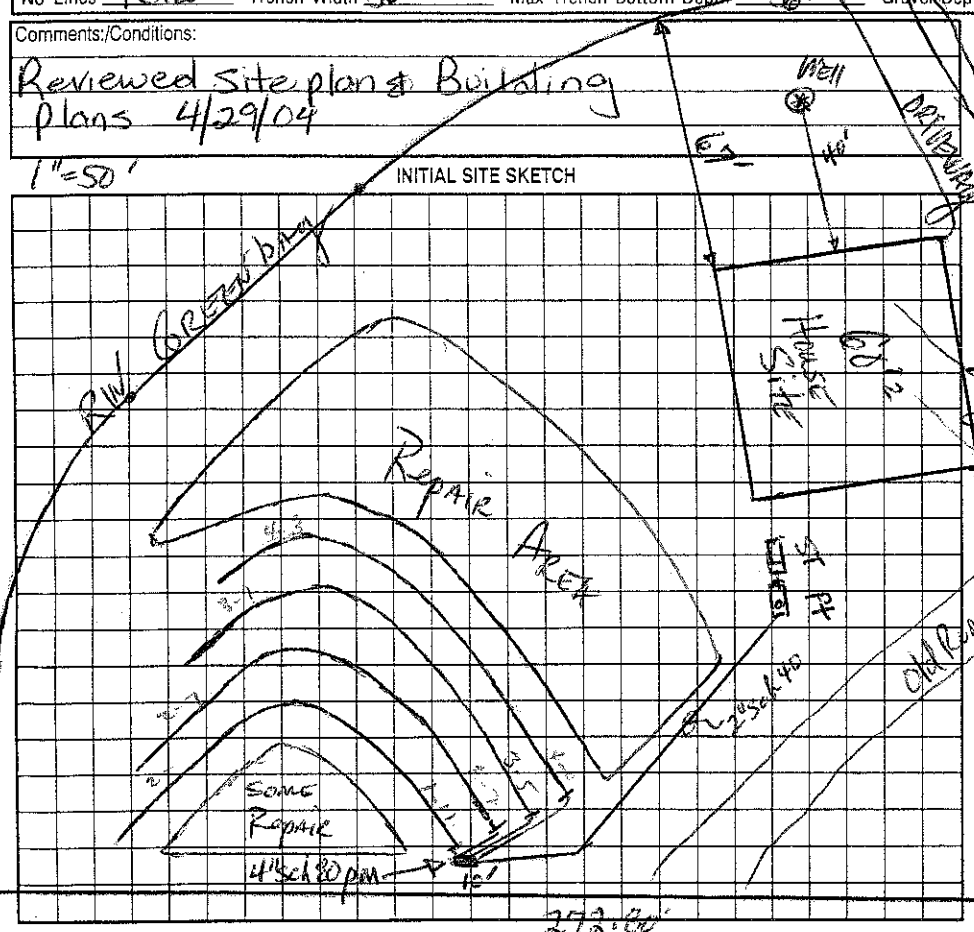

AS BUILT SKETCH

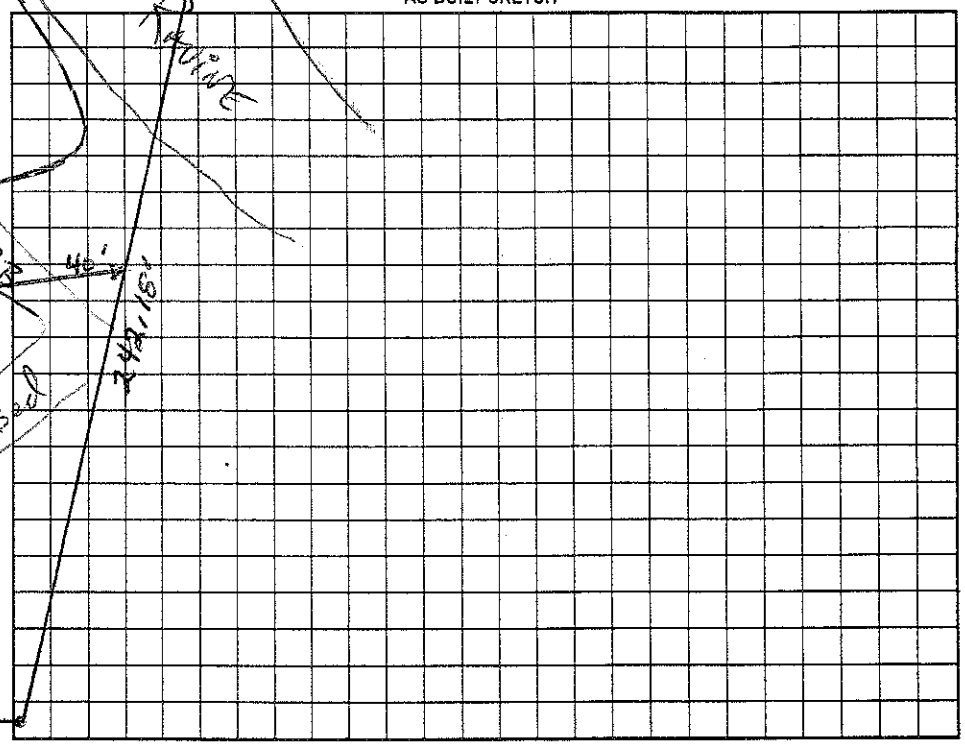

Permit can be suspended or revoked if any false information is supplied toward securing the permit/any unauthorized changes are made to the site/any unauthorized changes are made in the installation of the system. Improvement Permit with plat valid without expiration. Improvement Permit with site plan valid for sixty months. Authorization to Construct is valid for a period equal to that of Improvement Permit – not to exceed sixty months.

Signed: date 10-30-03 Installed by: Howard Builders

Improvement Permit by: Walter D. Hyman, RS date 9-29-03 Operation Permit by: RS date 11/1/04

Authorization to Construct by: Marina H. Dotson, RS date 4/29/04 Existing System Inspection by: date

HEALTH DEPT. COPY: WHITE OWNER COPY (FINAL): YELLOW OWNER COPY (INITIAL): PINK