IREDELL COUNTY HEALTH DEPARTMENT 4627766622.

Statesville Phone TR 3-7271 Mooresville Phone NO 3-1271

PERMIT TO INSTALL SEPTIC TANK

Permit No. Walt Puga Order, Permit Date Jan 16 1969

Owner R.L. Stevenson Address Winston Salem N.C.

Installed By C. Hoke & Sons Address R 7 CLST S10 Lot 132


Location of Property See 10 - Lake Norman - 150 West past Gilbert Quarry 1st dirt to left - hold main left, "A" frame on R 1 mile from 150.

Tank		Capacity		Length of Lines		Fixtures	
Block	( )	1000	(✓)	225'	(✓)	No. of Baths	(2)
Precast	(✓)	1250	( )	250'	( )	Dishwasher	( )
loads		1500	( )	Other		Garbage Grdr.	( )
		Other				Other	

NOTIFY HEALTH DEPARTMENT AT LEAST EIGHT HOURS BEFORE TANK IS TO BE INSPECTED.

Final Inspection 1-16 1969 Approved (✓) Disapproved ( )

Remarks well 60' - off lake 55' tank 36" under gound.

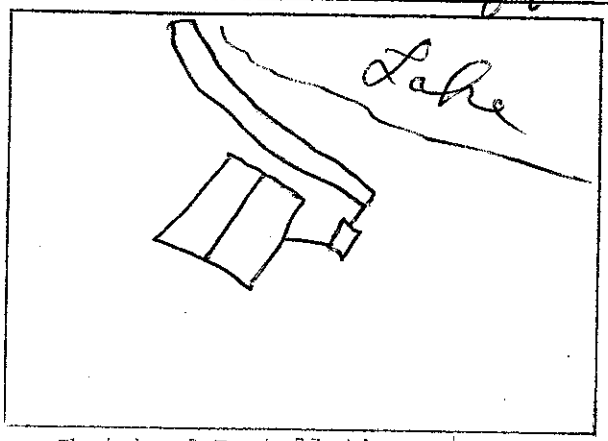

Sketch of Installation

T Scoggins Chas Dept

Sanitarian