IREDELL COUNTY HEALTH DEPARTMENT

Statesville Office (704) 878-5305 Mooresville Office (704) 660-3625 PERMIT # 216735

IMPROVEMENT PERMIT / AUTHORIZATION TO CONSTRUCT / OPERATION PERMIT / EXISTING SYSTEM

PIN # 4627-76-7683

APPLICANT: James Regehr APPLICANT ADDRESS: 306 Greenbay Drive

SITE ADDRESS: 306 Greenbay Drive Mooresville, NC PHONE: 704-878-7721 ALT. PHONE:

SITE DIRECTIONS: I-77 West towards Lake Norman → Left on Paradise Peninsula → Left onto Greenbay Rd.

SUBDIVISION: CL+T SECTION: 10 LOT # 131 LOT AREA: DESIGN FLOW: 360gal/day L.T.A.R.: Existing


Septic Tank Replace (1000)	(gal)	STB 700	Date 10-25	☐ New System ☒ Repair ☐ Expansion	System Type: I (II) III IV V VI	☒ Residence	No. Bedrooms 3	**Water Supply**
Pump Tank —	(gal)	PT —	Date —	System Description: —		☐ Business	No. Persons 6	☒ Private
Pump Make —	Model —		Serial # —	Repair System Description: Existing Bed Systems		☐ Other	No. Employees —	☐ Public
# Nitrification Fields 2	# Lines unk (3 trenches)		Linear Ft: unk (150)	Maintenance Agreement Required:	☐ YES ☒ NO	☐ Slab	☒ Crawl Space	☐ Community
Trench Width 36"	Max. Trench Bottom Depth unk		Gravel Depth 24"	☒ GRAVITY	☐ PRESSURE	☐ Basement w/plumbing	☐ Basement w/o plumbing	

Comments / Conditions: Existing collapsing septic tank originally served trailer (now removed). Explaining tanks orientation on opposite side of drainfield/bed area. Recommend uncovering Distribution Box(es) + ensuring proper calibration.

Existing tank to be abandoned. Recommend pumping new septic tank every 3-5 years.

FOR TANK REPLACEMENT ONLY

INITIAL SITE SKETCH

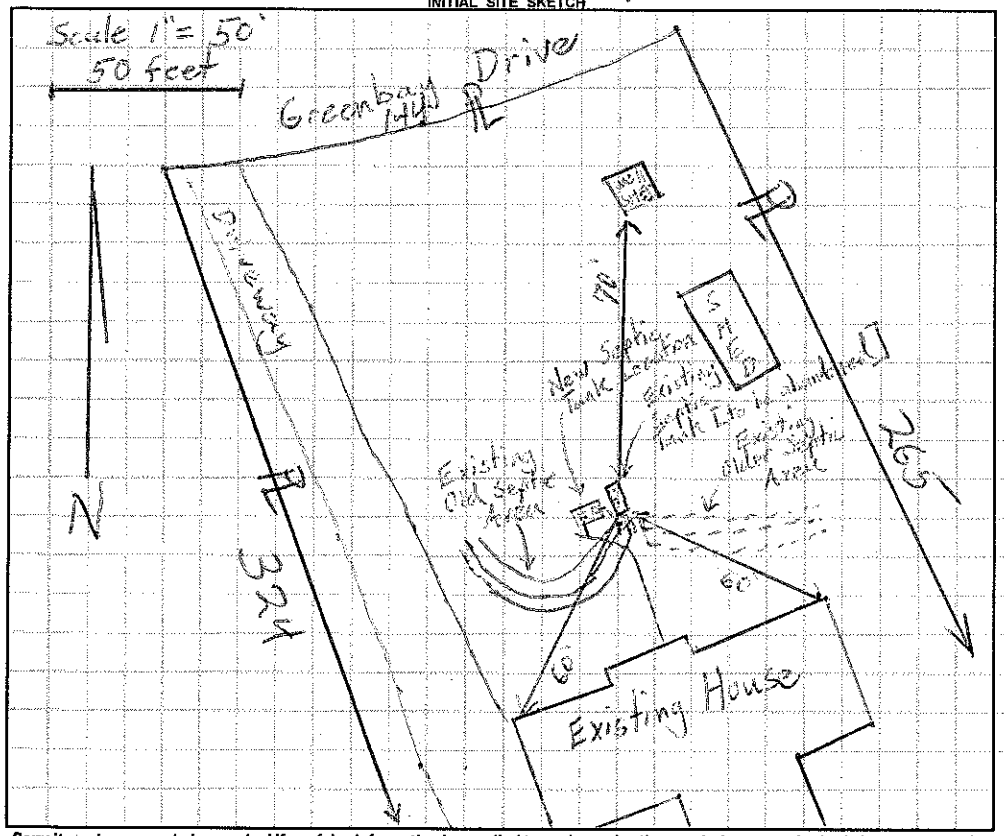

AS BUILT SKETCH

TANK INSTALLED AS SHOWN

Permit can be suspended or revoked if any false information is supplied toward securing the permit / any unauthorized changes are made to the site / any unauthorized changes are made in the installation of the system. **CONTACT A LOCATOR SERVICE PRIOR TO ANY EXCAVATION**

☐ **IMPROVEMENT PERMIT** *with plat valid without expiration.* ☒ **IMPROVEMENT PERMIT** *with site plan valid for 60 mos.* ☒ **AUTHORIZATION TO CONSTRUCT** *valid for period equal to IMPROVEMENT PERMIT--not to exceed 60 mo.*

Owner / Applicant Signature: James R Regehr Date: 3-8-16 Installed by:

IMPROVEMENT PERMIT by: Tom Shuck Date: 3-4-16 OPERATION PERMIT by: Date: 3-15-16

AUTHORIZATION TO CONSTRUCT by: Tom Shuck Date: 3-4-16 Existing System Inspected by: Date:

Health Dept. Copy - WHITE Applicant (Final Approval) - YELLOW Applicant (Conditional Approval) - PINK