IREDELL COUNTY HEALTH DEPARTMENT

STATESVILLE 704-878-5305 175.00 Paid MOORESVILLE 704-664-5281

IMPROVEMENT PERMIT / AUTHORIZATION TO CONSTRUCT / OPERATION PERMIT / EXISTING SYSTEM INSPECTION

PERMIT# 100461 PIN# 4627 77 2145 DATE 11-27-01

OWNER OR CONTRACTOR Donald Bonds PHONE: Business Home 663-1237

ADDRESS 276 Greenbay Rd Mooresville, NC 28117 276 Greenbay Rd

LOCATION Hwy 150 W TL Paradise Penn. 2nd street Greenbay ~6/10 mile on right

SUBDIVISION Lake Norman BLOCK / SECTION 10 LOT 152 LOT AREA .83 SITE CLASS. PS DESIGN FLOW 360gpd. L.T.A.R. .3

Septic Tank: 1000 Gallons; STB 194 Date 6-17-02
Pump Tank: 1000 Gallons; PT 27 Date 7-13-02
Pump Make: Model Serial No.
Nitrification Field: No Fields 1 Square Feet 240' Linear Feet 80'
No Lines 1 @ 80'+ Trench Width 36" Max Trench Bottom Depth 36"

☒ New System ☐ Repair System Type: I, II, III, IV, V, VI
System Description: Parade Pump - 25% Reduction
Repair System Description: Pump
Maintenance Agreement Required: ☐ Yes ☐ No
Gravel Depth N/A

☐ House/Mod. Home No. Bedrooms 3
☐ Mobile Home No. Bathrooms
☐ Business No. Employees
☐ Other Sewing room & Den must be "cased" entries
☐ Slab ☐ Crawl Space ☐ Basement w/plumbing ☐ Basement w/o plumbing


Water Supply:
☒ Individual
☐ Public
☐ Community

Add


Comments:/Conditions: Add 1-80'+ "Plastic Chamber" pline above existing drainfield.

Comments:/Conditions: If drainfield evaluation higher than "stub out" for plumbing than if must be pumped to Drainfield

INITIAL SITE SKETCH

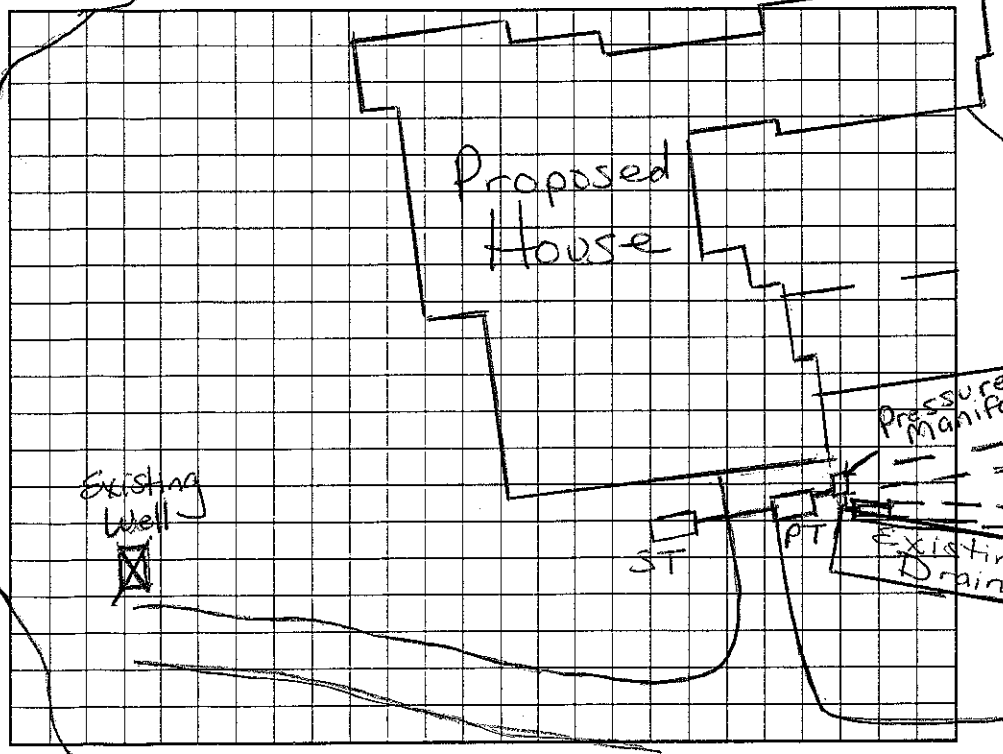

AS BUILT SKETCH

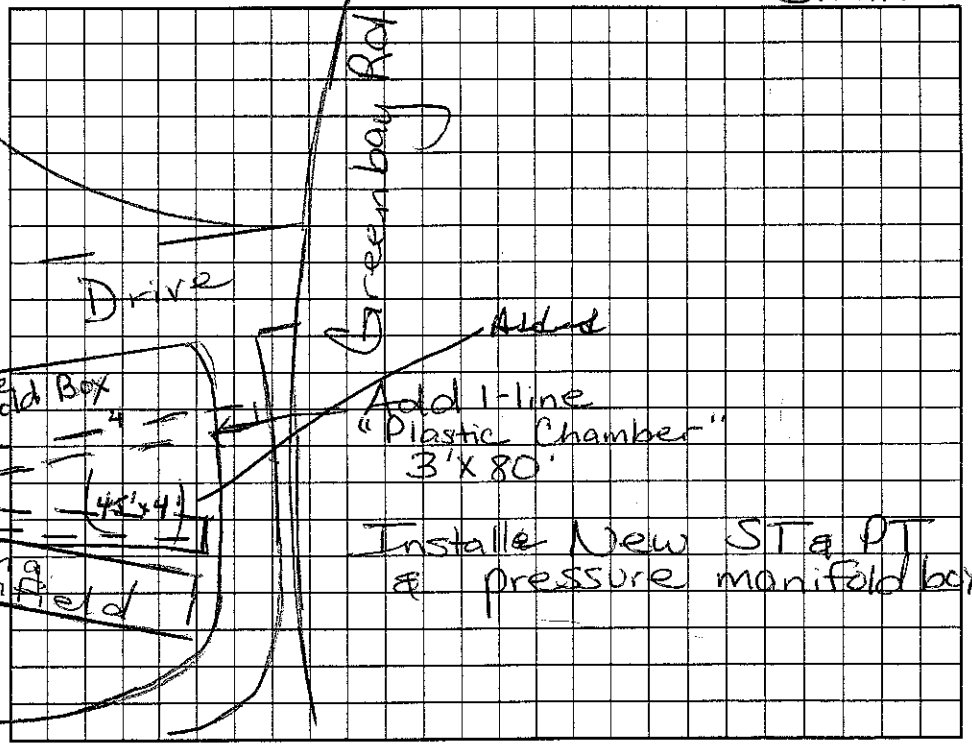

Permit can be suspended or revoked if any false information is supplied toward securing the permit/any unauthorized changes are made to the site/any unauthorized changes are made in the installation of the system. Improvement Permit with plat valid without expiration. Improvement Permit with site plan valid for sixty months. Authorization to Construct is valid for a period equal to that of Improvement Permit – not to exceed sixty months.

Signed: Ruth P. Bonds date 11-28-01

Improvement Permit by: Maria H. Dotson RS date 11/28/01

Authorization to Construct by: Maria H. Dotson RS date 11/28/01

Installed by: D&L Septic Tank Service

Operation Permit by: Wesley Sparks RS. date 9/11/02

Existing System Inspection by: date

HEALTH DEPT. COPY: WHITE OWNER COPY (FINAL): YELLOW OWNER COPY (INITIAL): PINK