IREDELL COUNTY HEALTH DEPARTMENT

Statesville Phone TR 3-7271 Mooresville Phone NO 3-1271

PERMIT TO INSTALL SEPTIC TANK

Permit NO. _____ Permit Date 12 Aug 1969

Owner Jack Mathews Address Greensboro N C

Installed By Stewart Address Troutman N.C.

Location of Property Set 10 - acres


N. White Property Lot 157

Tank		Capacity		Length of Lines		Fixtures	
Block	( )	1000	(✓)	225'	(✓)	No. of Baths	( )
Precast	(✓)	1250	( )	250'	( )	Dishwasher	( )
		1500	( )	Other _____		Garbage Grdr.	( )
		Other _____				Other _____	

NOTIFY HEALTH DEPARTMENT AT LEAST EIGHT HOURS BEFORE TANK IS TO BE INSPECTED.

Final Inspection 12 Aug 1969 Approved (X) Disapproved ( )

Remarks _____

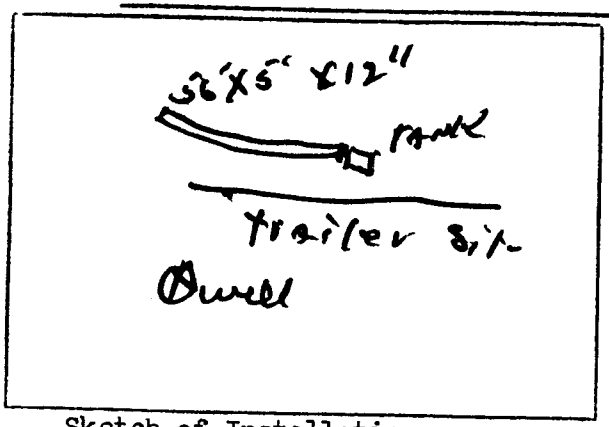

Sketch of Installation

Ivy Sawyer, RS

Sanitarian