IREDELL COUNTY HEALTH DEPARTMENT

STATESVILLE 704-878-5305 280.00 Paid MOORESVILLE 704-664-5281 3:00

IMPROVEMENT PERMIT / AUTHORIZATION TO CONSTRUCT / OPERATION PERMIT / EXISTING SYSTEM INSPECTION

PERMIT# 17330 PIN# ~~4627729337~~ 4627729165 DATE 3-17-04

OWNER OR CONTRACTOR Crendell Herrin PHONE: Business (336) 972-8117 Home 336 922-2582

ADDRESS 4295 Whispering Oak Dr. Winston Salem, NC 27106

LOCATION Hwy 150 West TL Paradise Peninsula TL Green Bay TR Milledge

SUBDIVISION Cl. 1 BLOCK / SECTION 10 LOT 164 LOT AREA .66 Acre SITE CLASS. PS DESIGN FLOW 480 gpd T.A.R. .3

Septic Tank: 1000 Gallons; STB 794 Date 5-20-05

Pump Tank: ____ Gallons; PT ____ Date ____

Pump Make: ____ Model ____ Serial No. ____

Nitrification Field: No Fields 1 Square Feet 810 Linear Feet 270

No Lines 6@45' Trench Width 24"-36" Max. Trench Bottom Depth 30" Gravel Depth N/A

☒ New System ☐ Repair System Type: I II III IV V VI

System Description: Gravity - Panel Blk

Repair System Description: Partial - Panel Blk

Maintenance Agreement Required: ☐ Yes ☐ No

☒ House/Mod. Home ☐ Mobile Home ☐ Business ☐ Other

No. Bedrooms 4 No. Bathrooms 4 No. Employees ____

☐ Slab ☐ Crawl Space ☐ Basement w/plumbing ☐ Basement wo/plumbing


Water Supply: ☒ Individual ☐ Public ☐ Community

Comments:/Conditions:

Comments:/Conditions: * Lot deeded / platted prior to 1983. Keep Septic System at least 10' From PL & 50' From Lake & 50-100' From well


Scale 1:40

INITIAL SITE SKETCH

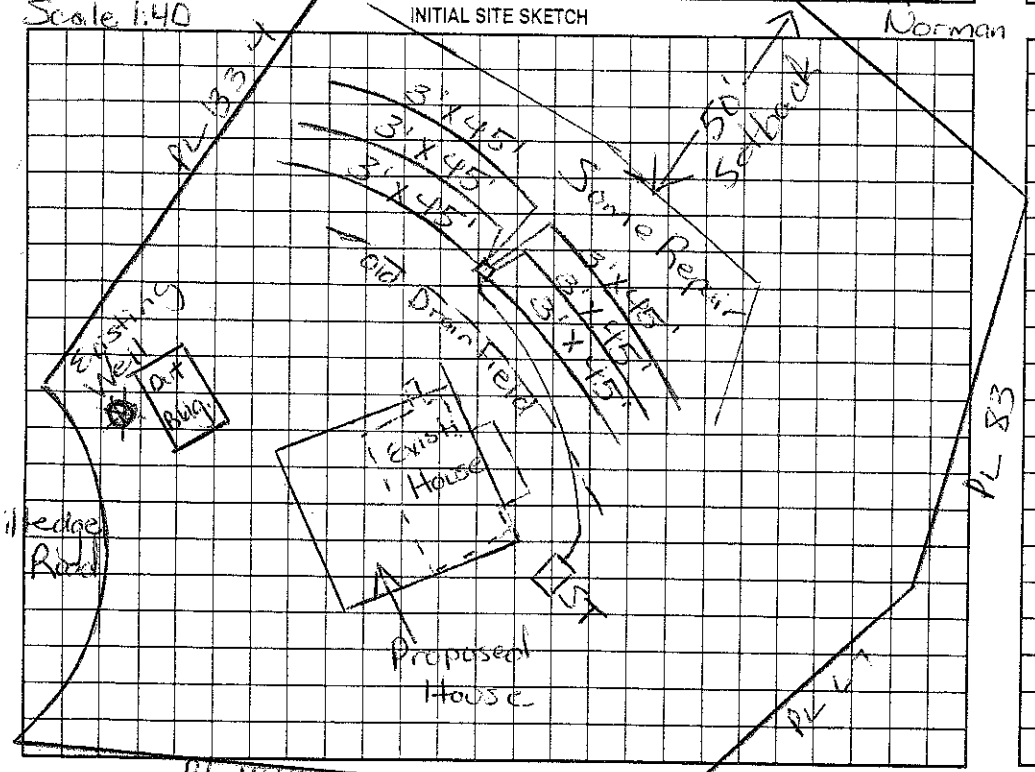

AS BUILT SKETCH

Checked lines & tank 6/24/05 MR

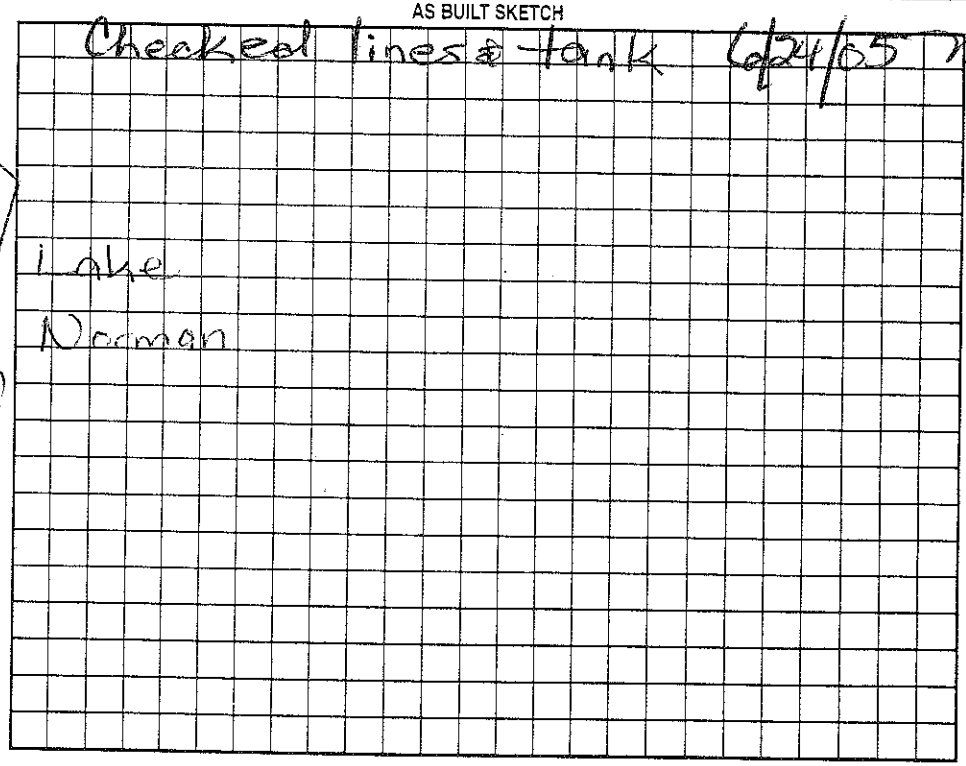

Permit can be suspended or revoked if any false information is supplied toward securing the permit/any unauthorized changes are made to the site/any unauthorized changes are made in the installation of the system. Improvement Permit with plat valid without expiration. Improvement Permit with site plan valid for sixty months. Authorization to Construct is valid for a period equal to that of Improvement Permit – not to exceed sixty months.

Signed: Crendell Herrin date 3-18-04

Improvement Permit by: Maria H. Dotson RS date 3/17/04

Authorization to Construct by: Maria H. Dotson RS date 3/17/04

Installed by: Richard Abernathy

Operation Permit by: Wesley Sparks RS date 6/27/05

Existing System Inspection by: ____ date ____

HEALTH DEPT. COPY: WHITE OWNER COPY (FINAL): YELLOW OWNER COPY (INITIAL): PINK