IREDELL COUNTY HEALTH DEPARTMENT

STATESVILLE 704-878-5305 MOORESVILLE 704-664-5281

IMPROVEMENT PERMIT / AUTHORIZATION TO CONSTRUCT / OPERATION PERMIT / EXISTING SYSTEM INSPECTION

PERMIT# 132421 PIN# 4627 77 7681 DATE 9/12/06

OWNER OR APPLICANT Johnny Ray Simmons PHONE: Business 704-402-4166 Home

ADDRESS 252 Bleachery Rd. Mooresville, NC. 28117

LOCATION I-50 W to Pendleton Peninsula to Green Bay Rd to 252 on R

SUBDIVISION CL+T BLOCK / SECTION 10 LOT 1141 LOT AREA 1.094 SITE CLASS. PS DESIGN FLOW 360 L.T.A.R.

Septic Tank: EXISTING Gallons: System Date

Pump Tank: Gallons: PT Date

Pump Make: Model Serial No.

Nitrification Field: No Fields EXISTING SYSTEM Square Feet Linear Feet

No Lines Trench Width Max Trench Bottom Depth Gravel Depth ☐ Gravity ☒ Pressure

☐ New System ☐ Repair ☐ Expansion System Type: I II III IV V VI

System Description:

Repair System Description:

Maintenance Agreement Required: ☒ Yes ☐ No

☐ House/Mod. Home No. Bedrooms

☐ Mobile Home No. Persons

☐ Business No. Employees

☐ Other


Water Supply: ☐ Individual ☐ Public ☐ Community

☐ Slab ☐ Crawl Space ☐ Basement w/plumbing ☐ Basement wo/plumbing


Comments:/Conditions:

Comments:/Conditions: Maintenance Contract Required

~~INITIAL SITE SKETCH~~ EXISTING SYSTEM

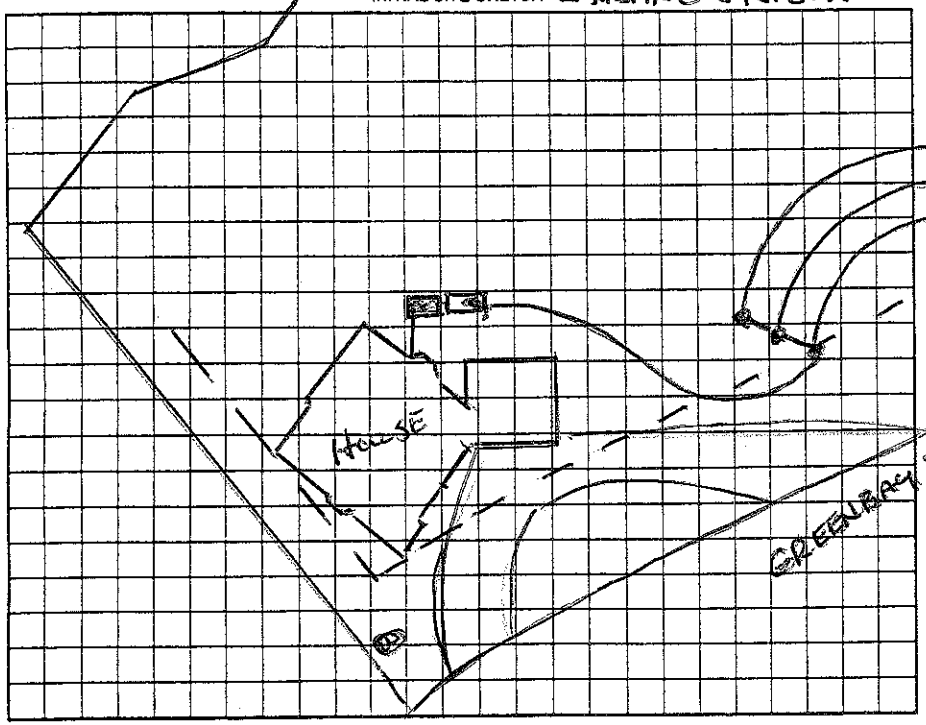

AS BUILT SKETCH

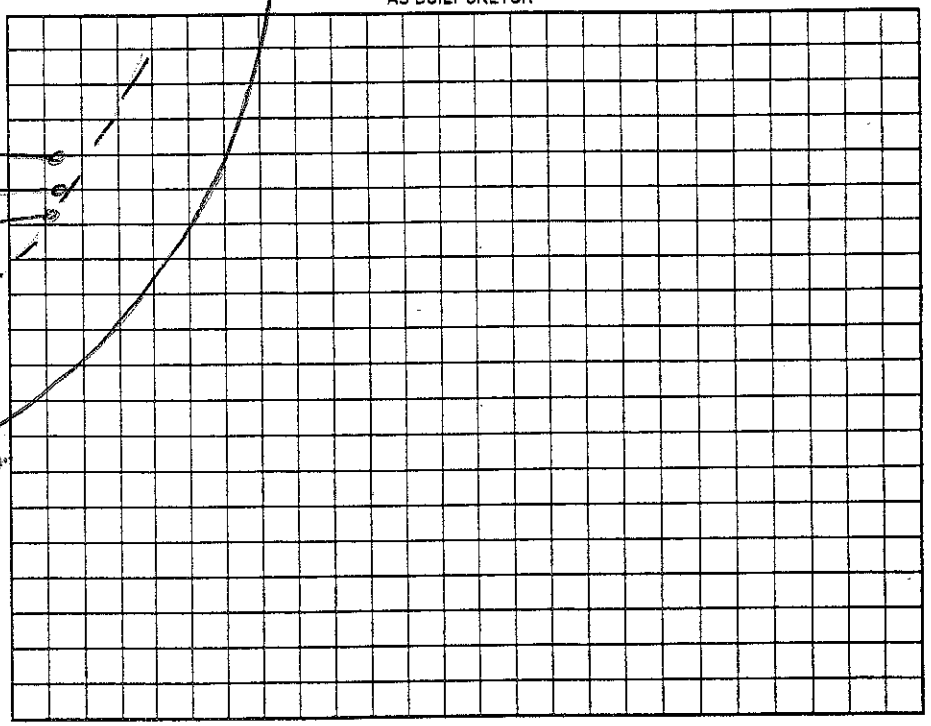

Permit can be suspended or revoked if any false information is supplied toward securing the permit/any unauthorized changes are made to the site/any unauthorized changes are made in the installation of the system. Improvement Permit with plat valid without expiration ☐ Improvement Permit with site plan valid for sixty months ☐ Authorization to Construct is valid for a period equal to that of Improvement Permit – not to exceed sixty months.

Signed: date 09-12-06

Improvement Permit by: date

Authorization to Construct by: date

Installed by: Ray Bream

Operation Permit by: date

Existing System Inspection by: Wesley Sparks RS date 9/12/06

HEALTH DEPT. COPY: WHITE OWNER COPY (FINAL): YELLOW OWNER COPY (INITIAL): PINK