IREDELL COUNTY HEALTH DEPARTMENT

STATESVILLE 704-878-5305 MOORESVILLE 704-[illegible]281

130

IMPROVEMENT PERMIT / AUTHORIZATION TO CONSTRUCT / OPERATION PERMIT / EXISTING SYSTEM INSPECTION

PERMIT# 114304 PIN# 4627-88-5496.020 4627-77-8055 DATE October 27, 2003

OWNER OR CONTRACTOR Greenbay Forest LLC / Ray Short PHONE: Business Home

ADDRESS P.O. Box 3608 Mooresville, N.C. 28117

LOCATION 151 West TL Paradise Peninsula TL Greenbay on left

SUBDIVISION Greenbay Forest BLOCK / SECTION LOT 20/20A LOT AREA 1Ac ± .44Ac SITE CLASS SFE 20A DESIGN FLOW 460gpd L.T.A.R. .3 (SFE)

Septic Tank: 1000 Gallons; STB 294 Date

Pump Tank: 1000 Gallons; PT 27 Date

Pump Make: Gould's Model WE80124H Serial No.

Nitrification Field: No Fields 1 Square Feet 1200 Linear Feet 400

No Lines 4 @ 100 Trench Width 36" Max Trench Bottom Depth 36" Gravel Depth NA

☑ New System ☐ Repair System Type: I, II, III, IV, V, VI

System Description: PM-25% Reduction on SFE 20A

Repair System Description: PM/LP 25% Reduction on SITE 20A

Maintenance Agreement Required: ☐ Yes ☑ No

☑ House/Mod. Home No. Bedrooms 4

☐ Mobile Home No. Bathrooms 4

☐ Business No. Employees

☐ Other


☐ Slab ☑ Crawl Space ☐ Basement w/plumbing ☐ Basement wo/plumbing

Water Supply: ☑ Individual ☐ Public ☐ Community


Comments:/Conditions: Reviewed Building plans, essentially in Compliance with original permit.

Comments:/Conditions:

INITIAL SITE SKETCH 1" = 100'

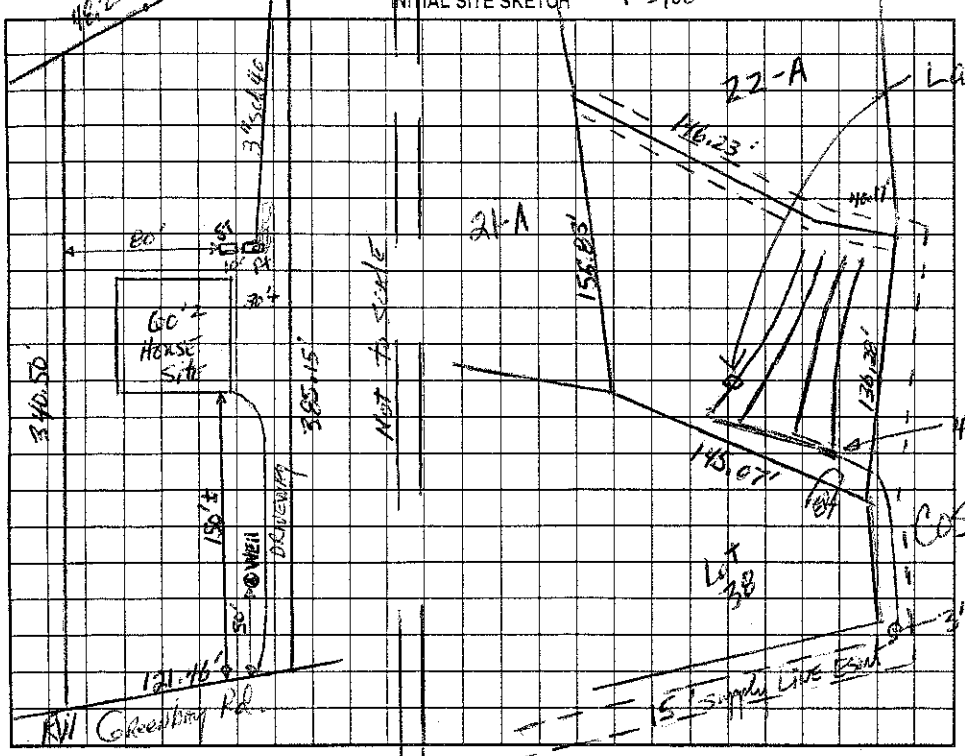

AS BUILT SKETCH

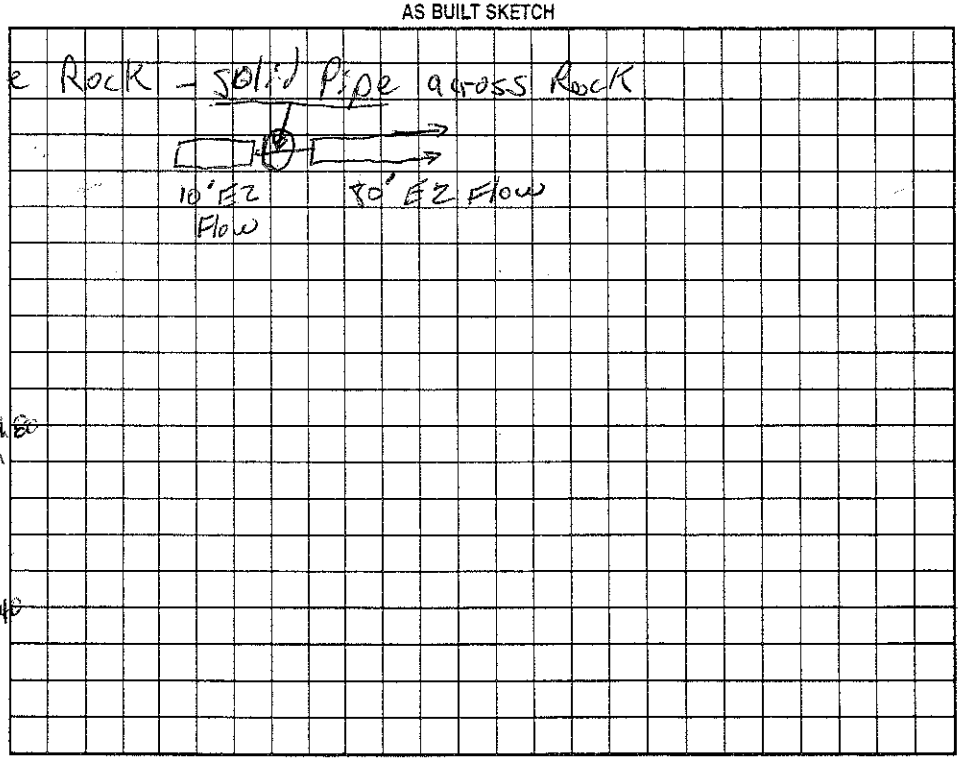

Permit can be suspended or revoked if any false information is supplied toward securing the permit/any unauthorized changes are made to the site/any unauthorized changes are made in the installation of the system. Improvement Permit with plat valid without expiration. Improvement Permit with site plan valid for sixty months. Authorization to Construct is valid for a period equal to that of Improvement Permit – not to exceed sixty months.

Signed: date 10-30-03 Installed by: Howard S Backhoe

Improvement Permit by: date 10-27-03 Operation Permit by: RS date 10/7/04

Authorization to Construct by: RS date 1/22/04 Existing System Inspection by: date

HEALTH DEPT. COPY: WHITE OWNER COPY (FINAL): YELLOW OWNER COPY (INITIAL): PINK