Repair 3.00

IREDELL COUNTY HEALTH DEPARTMENT

STATESVILLE 704-878-5305 MOORESVILLE 704-664-5281

IMPROVEMENT PERMIT / AUTHORIZATION TO CONSTRUCT / OPERATION PERMIT / EXISTING SYSTEM INSPECTION

PERMIT # Repair PIN # 4627780846.000 DATE 3/24/09

OWNER or APPLICANT John Godfrey PHONE: Business Home:

OWNER or APPLICANT ADDRESS 179 Paradise Peninsula Dr.

LOCATION / DIRECTIONS 150 w TL Paradise Peninsula Dr on Left 179 Peninsula Dr.

SUBDIVISION CLST BLOCK / SECTION 10 LOT # 183 LOT AREA DESIGN FLOW 480 L.T.A.R. GW5

Septic Tank New 1000 Gallons: STB 760 Date 12/26/08
Pump Tank Gallons: P T Date
Pump Make Model Serial #
Nitrification Field No Fields No Lines Linear Feet
Trench Width Max. Trench Bottom Depth Gravel Depth

☐ New System ☐ Repair ☐ Expansion System Type I (II) III IV V VI
System Description: Replace Septic Tank
Repair System Description:
Maintenance Agreement Required ☐ YES ☐ NO
☐ GRAVITY ☐ PRESSURE


☐ Residence No. Bedrooms 4
☐ Business No. Persons
☐ Other No. Employees
☐ Slab ☐ Crawl Space
☐ Basement w/plumbing ☐ Basement w/o plumbing

Water Supply
☑ Private well
☐ Public GW5
☐ Community

Comments / Conditions

(NTS)

INITIAL SITE SKETCH

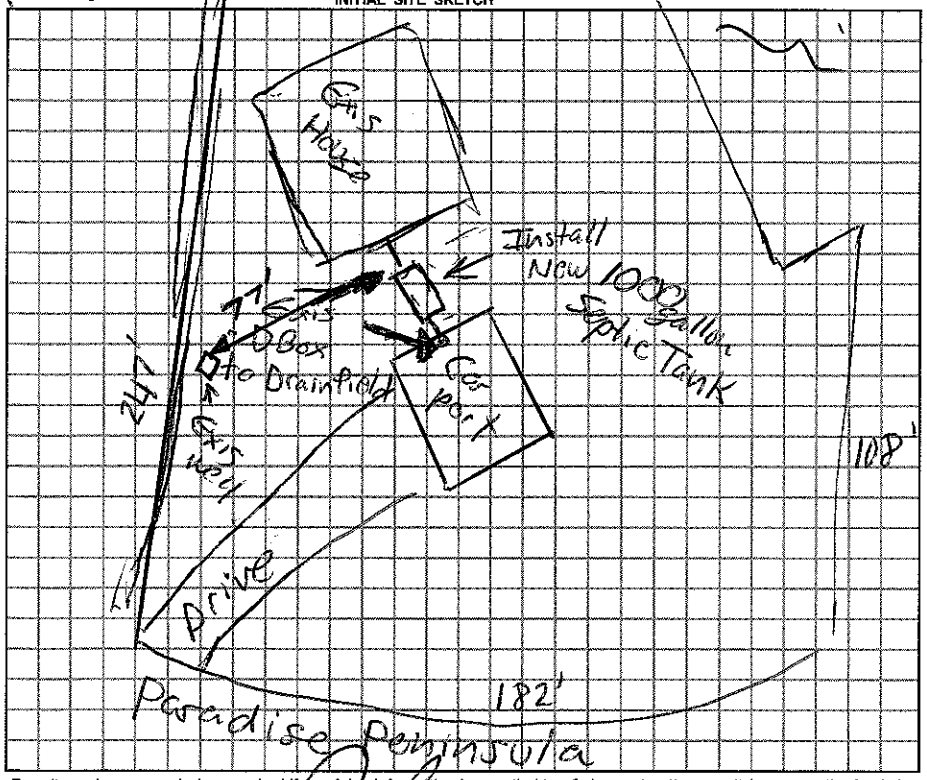

Comments / Conditions Exist tank caving in, replace with new 1000 gallon septic tank, Keep min 5' from building foundation or max feasible.

AS BUILT SKETCH

3/30/09 Tank installed as shown AG

Permit can be suspended or revoked if any false information is supplied toward securing the permit / any unauthorized changes are made to the site / any unauthorized changes are made in the installation of the system.

☐ *IMPROVEMENT PERMIT w / plat valid without expiration* ☐ *IMPROVEMENT PERMIT w / site plan valid for 60 mos.* ☐ *AUTHORIZATION TO CONSTRUCT valid for period equal to IMPROVEMENT PERMIT-not to exceed 60 mo.*

Owner / Applicant Signature: Date

Improvement Permit by: Anthony Coker Jr. R.S. Date 3/24/09

Authorzation to Construct by: Anthony Coker Jr. R.S. Date 3/24/09

YOU SHOULD CONTACT A LOCATOR SERVICE PRIOR TO ANY EXCAVATION.

Installed by: Jared Lontz

Operation Permit by: Anthony Coker Jr. R.S. Date: 3/30/09

Existing System Inspected by: Date:

WHITE COPY Environmental Health YELLOW COPY (Final) Owner / Applicant PINK COPY (Initial) Owner / Applicant