ELL COUNTY HEALTH DEPARTMENT

Auth — Initial Construct — 3 BR

ATESVILLE 704-878-5305 MOORESVILLE 704-664-5281

IMPROVEMENT PERMIT / ~~CERTIFICATE OF COMPLETION~~ / OPERATION PERMIT / EXISTING SYSTEM INSPECTION

PROPERTY DESCRIPTION NO. 26375 DATE 3/21/97 TAX MAP NO. 4627783176 Watershed: X Yes ☐ No

OWNER OR CONTRACTOR RW BAREFOOT PHONE: Business Home 664-1155 WS IV CA

ADDRESS 116 MILLEDGE DR MOORESVILLE

LOCATION 150 W TL PARADISE PEN. TL GREENBAY TR MILLEDGE DR. HOUSE ON (R) 116 Milledge Dr.

SUBDIVISION CL+T BLOCK / SECTION 10 LOT 165 LOT AREA 7 1AC SITE CLASS. PS DESIGN FLOW 360 L.T.A.R. .20

Septic Tank: 1000 Gallons; STB 744 Date 3/6/97

Pump Tank: 1000 Gallons; PT 27 Date 4/8/97

Pump Make: GOULDS Model 1350 Serial No. 450

Nitrification Field: No Fields 1 Square Feet ~~1600~~ X Linear Feet ~~X 100~~

No Lines 5 Trench Width 36" Max Trench Bottom Depth 30" Gravel Depth SAND

X New System ☐ Repair System Type: I, II, III, IV, V, VI

System Description: 1250 Mon → CH PLASTIC

Repair System Description: SAME

Maintenance Agreement Required: ☐ Yes X No

X House/Mod. Home No. Bedrooms 3

☐ Mobile Home No. Bathrooms 2

☐ Business No. Employees

☐ Other

☐ Slab ☐ Crawl Space X Basement w/plumbing ☐ Basement wo/plumbing

Water Supply: X Individual ☐ Community ☐ Public

Comments: X 25% REDUCTION FOR CH. PLASTIC USE


Serial- C9742313

Model


Comments:

3 450 1 2-700

INITIAL SITE SKETCH

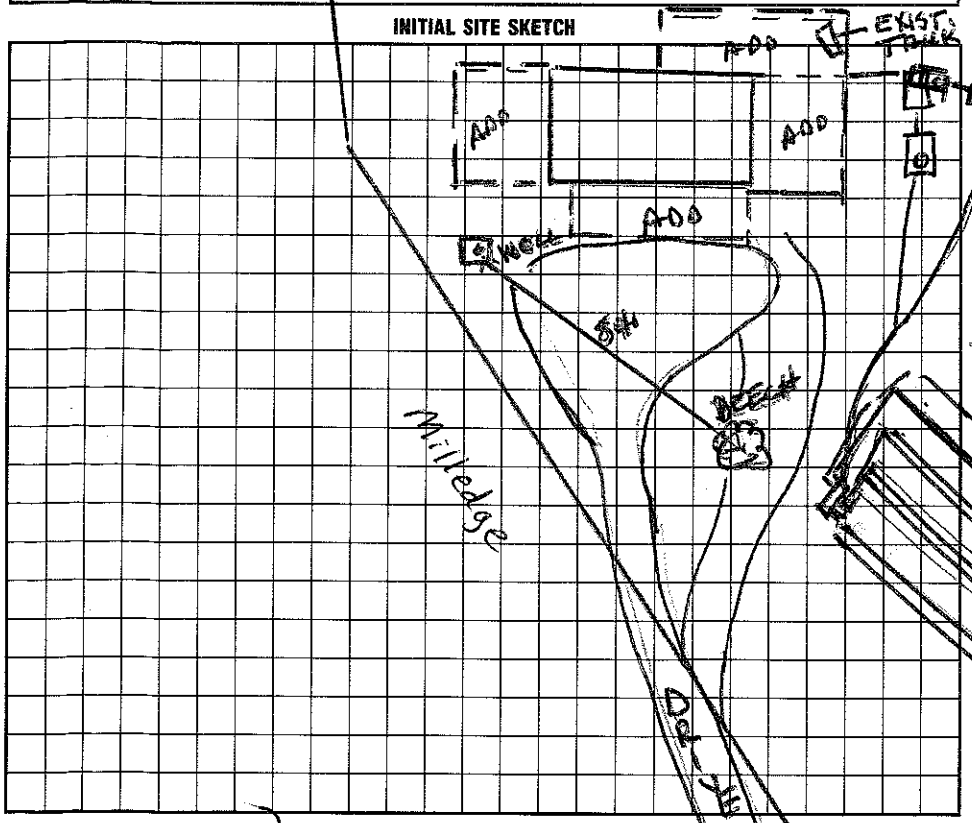

AS BUILT SKETCH

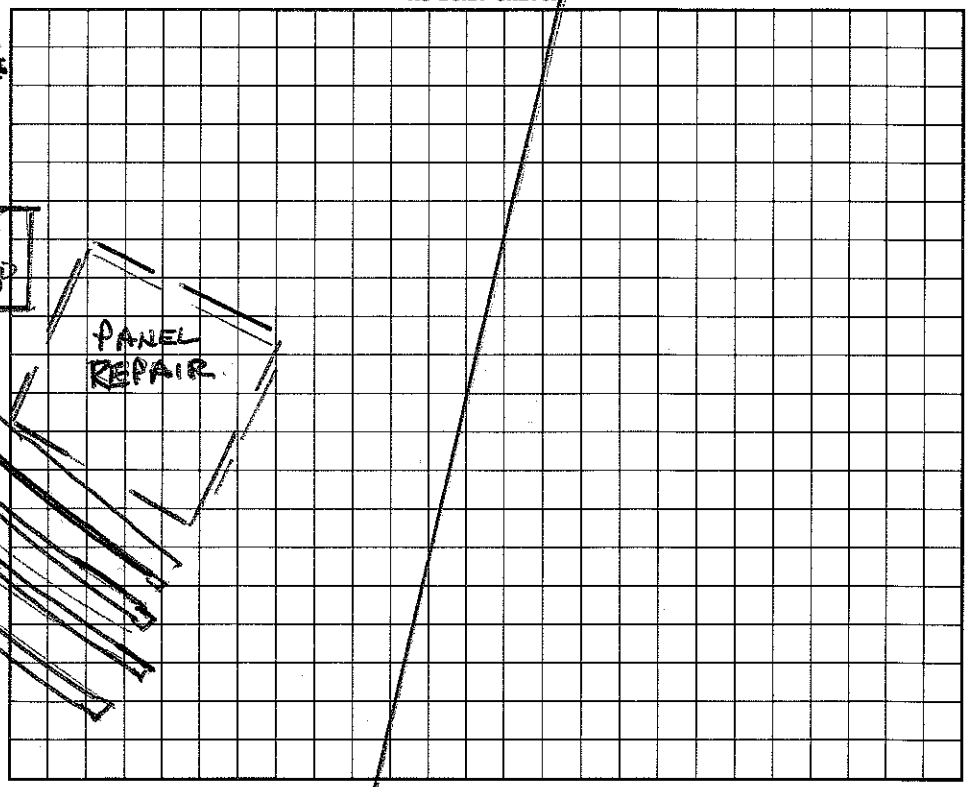

I understand that this permit can be suspended or revoked if any false information is supplied toward securing the permit/any unauthorized changes are made to the site/any unauthorized changes are made in the installation of the system. Improvement Permit is valid for 60 months from date of issuance.

Signed: X

Installed by: FS ERVIN

Improvement Permit by: Wesley Sparks RS. date 3/21/97

Certificate of Completion by: Wesley Sparks RS. date 1/26/98

~~Authorized~~ Existing System Inspection by: Wesley Sparks RS. date 3/24/97

Operation Permit by: Wesley Sparks RS date 1/26/98

HEALTH DEPT. COPY: WHITE INSPECTION COPY (FINAL): GREEN OWNER COPY (FINAL): YELLOW INSPECTION COPY (INITIAL): PINK OWNER COPY (INITIAL): GOLD