130

IREDELL COUNTY HEALTH DEPARTMENT

STATESVILLE 704-878-5305 MOORESVILLE 704-664-5281

IMPROVEMENT PERMIT / AUTHORIZATION TO CONSTRUCT / OPERATION PERMIT / EXISTING SYSTEM INSPECTION

PERMIT# 113389 PIN# ~~4627-86-5496.000~~ Select 4627-18-7363 DATE Sept 11, 03

OWNER OR CONTRACTOR Bridgewater LLC / Greenbay Forest LLC / Properties PHONE: Business (704) 947-8927 Home

ADDRESS P.O. Box 3608, Mooresville, N.C. 28117

LOCATION 150 WEST TL PARADISE PENINSULA TL GREENBAY on left

SUBDIVISION Greenbay Forest BLOCK / SECTION LOT 10 LOT AREA 1.02 AC SITE CLASS. PS DESIGN FLOW 480 gpd L.T.A.R. .03

Septic Tank: 1000 Gallons; STB 312 Date 10/16/04

Pump Tank: Gallons; PT Date

Pump Make: Model Serial No.

Nitrification Field: No Fields 1 Square Feet 1200 Linear Feet 400

No Lines 4 Trench Width 36" Max Trench Bottom Depth 36" Gravel Depth N/A

☑ New System ☐ Repair System Type: I, II, (III), IV, V, VI

System Description: Gravity 25% Reduction

Repair System Description: Gravity pumped 25-50% Reduction

Maintenance Agreement Required: ☐ Yes ☑ No

☑ House/Mod. Home No. Bedrooms 4

☐ Mobile Home No. Bathrooms 4

☐ Business No. Employees

☐ Other

☐ Slab ☑ Crawl Space ☐ Basement w/plumbing ☐ Basement wo/plumbing


Water Supply: ☑ Individual ☐ Public ☐ Community

Comments:/Conditions:


Comments:/Conditions: Note: Moving well slightly back but site plan will work with original permit MS

1" = 50'

INITIAL SITE SKETCH

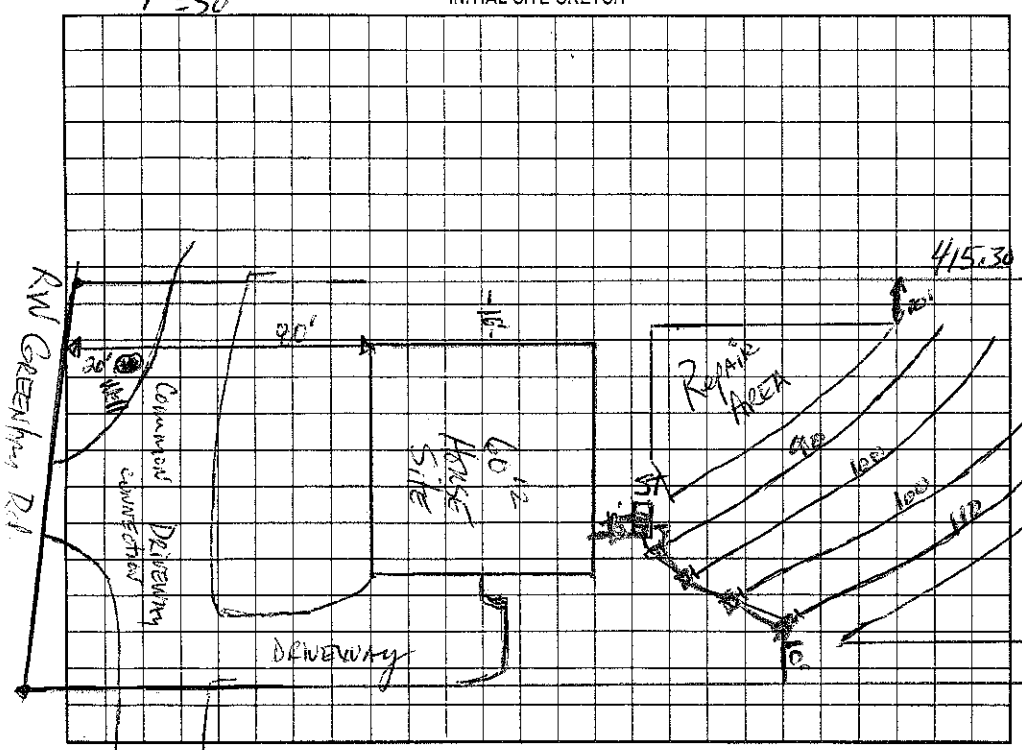

AS BUILT SKETCH

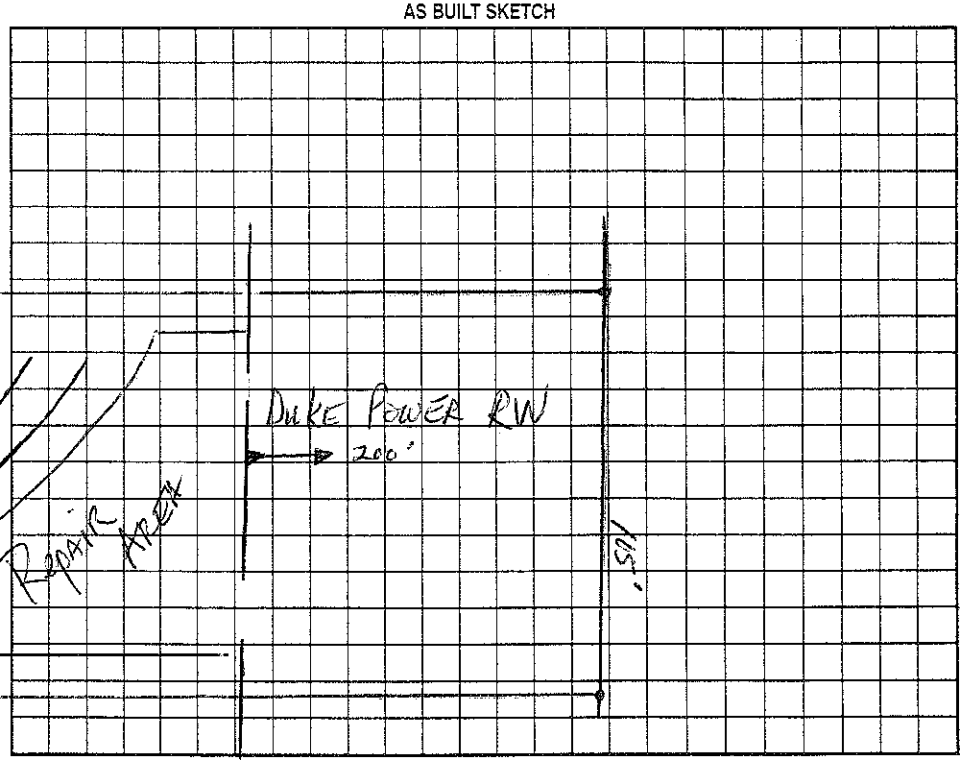

Permit can be suspended or revoked if any false information is supplied toward securing the permit/any unauthorized changes are made to the site/any unauthorized changes are made in the installation of the system. Improvement Permit with plat valid without expiration. Improvement Permit with site plan valid for sixty months. Authorization to Construct is valid for a period equal to that of Improvement Permit -- not to exceed sixty months.

Signed: date 10-30-03 Installed by: Kevin Hollomon

Improvement Permit by: date 9-11-03 Operation Permit by: Wesley Sparks RS date 11/22/04

Authorization to Construct by: date 2/19/04 Existing System Inspection by: date

HEALTH DEPT. COPY: WHITE OWNER COPY (FINAL): YELLOW OWNER COPY (INITIAL): PINK