
P01

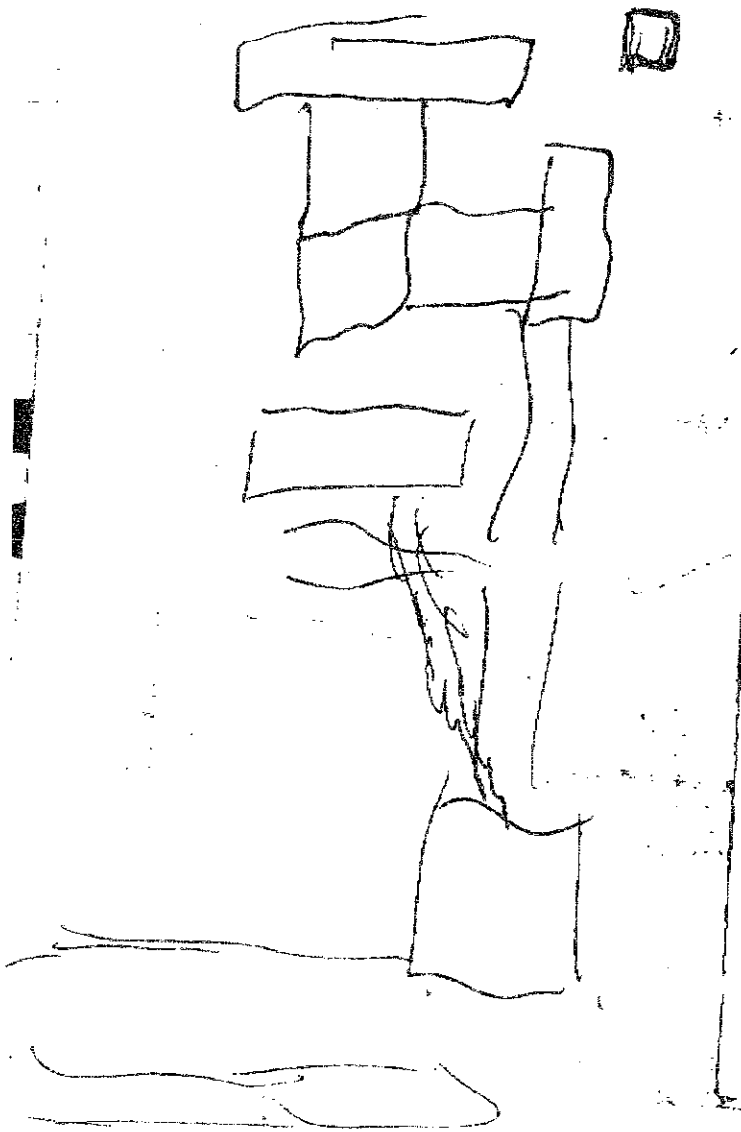

IREDELL COUNTY HEALTH DEPARTMENT

Statesville Phone TR 3-7271 Mooresville Phone NO 3-127

PERMIT TO INSTALL SEPTIC TANK

Permit NO. _____ Permit Date 10 Sept 19 72

Owner Mr. Sloan Address Charlotte

Installed By Setzer Address Catawba

Location of Property _____

Tank

Block ( ) Capacity 1000 ( ) Length of Lines 225' ( ) Fixtures No. of Baths ( )

Precast (✓) 1250 ( ) 250' ( ) Dishwasher ( )

1500 ( ) Other _____ ( ) Garbage Grdr. ( )

Other _____ Other _____

NOTIFY HEALTH DEPARTMENT AT LEAST EIGHT HOURS BEFORE TANK IS TO BE INSPECTED

Final Inspection 10 Sept 19 72

Remarks _____ Approved (X) Disapproved ( )

Well

Trailer

Line

Road

Sketch of Installation

Greg Scoggins

Sanitarian

12/23/99 08:14 FAX 704+536+2280 WHAT'S HAPPENING 003