IREDELL COUNTY HEALTH DEPARTMENT

STATESVILLE 704-878-5305 MOORESVILLE 704-664-5281

10:00

IMPROVEMENT PERMIT / AUTHORIZATION TO CONSTRUCT / OPERATION PERMIT / EXISTING SYSTEM INSPECTION

PERMIT# 130633 PIN# 4627793467 DATE 9-30-05

OWNER OR CONTRACTOR Beeson Builders (owner Steve Schafter) PHONE: Business 704-363-9930 Home

ADDRESS 18200 Pompano Place Cornelius 28031

LOCATION Hwy 150 west TL Paradise Penninsula house on right 146 Paradise Penninsula Mooresville

SUBDIVISION CLFT BLOCK / SECTION 10 LOT 214 LOT AREA .69 Ac SITE CLASS PS DESIGN FLOW 120gpd L.T.A.R. .25

Septic Tank: Existing Gallons; STB Date

Pump Tank: 1000 gal.) Gallons; PT Date

Pump Make: Model Serial No.

Nitrification Field: No Fields 1 Square Feet Linear Feet 120'

No Lines 1 Trench Width 36" Max Trench Bottom Depth Gravel Depth NA

☒ New System ☐ Repair System Type: I, II, III, IV, V, VI

System Description: 25% reduction, gravity

Repair System Description: 25% reduction, pump

Maintenance Agreement Required: ☐ Yes ☒ No

☒ House/Mod. Home No. Bedrooms 4

☐ Mobile Home No. Bathrooms

☐ Business No. Employees

☐ Other


☐ Slab ☐ Crawl Space ☒ Basement w/plumbing ☐ Basement wo/plumbing

Water Supply: ☒ Individual ☐ Public ☐ Community

Comments:/Conditions: 1) New drop box and trench line added to existing line and tank 2) New line to accommodate additional bedroom. 3) Existing system permitted for 3 bedrooms is undersized according to today's standards. 4) New supply added to tank for new construction. 5) 6' undisturbed soil between existing and new trench

Comments:/Conditions:

INITIAL SITE SKETCH 1"=50'

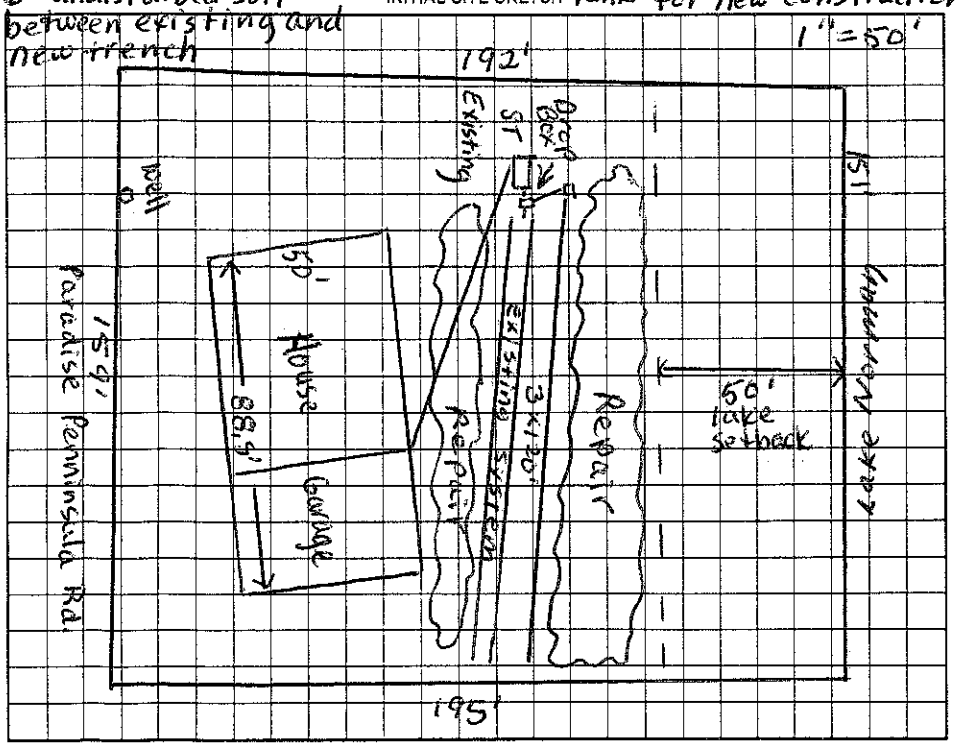

AS BUILT SKETCH

Installed as Drawn

Used Quick 4

Permit can be suspended or revoked if any false information is supplied toward securing the permit/any unauthorized changes are made to the site/any unauthorized changes are made in the installation of the system. Improvement Permit with plat valid without expiration. Improvement Permit with site plan valid for sixty months. Authorization to Construct is valid for a period equal to that of Improvement Permit - not to exceed sixty months.

Signed: [signature] date 9/30/05 Installed by: Willie Christenbury

Improvement Permit by: Judy Melville date 9-30-05 Operation Permit by: Maria H. Dolan RS date 3/17/06

Authorization to Construct by: Judy Melville date 9-30-05 Existing System Inspection by: date

HEALTH DEPT. COPY: WHITE OWNER COPY (FINAL): YELLOW OWNER COPY (INITIAL): PINK