4027795258

IREDELL COUNTY HEALTH DEPARTMENT

STATESVILLE 704-878-5305 MOORESVILLE 704-664-5281

IMPROVEMENT PERMIT / CERTIFICATE OF COMPLETION / OPERATION PERMIT / EXISTING SYSTEM INSPECTION

PROPERTY DESCRIPTION NO. 17653 DATE Jan. 4, 1994 TAX MAP NO. 2L6A179 Watershed: ☑ Yes ☐ No

OWNER OR CONTRACTOR Michael Dean Hepler PHONE: Business 873-7237 Home L.N.

ADDRESS Rt 2 Box 166 Hiddenbay NC 28634

LOCATION 150 W TL Paradise Peninsula at corner w/ Greenbay Rd.

SUBDIVISION Crescent LN BLOCK / SECTION 40 LOT 179 LOT AREA 2.89Ac SITE CLASS. PS DESIGN FLOW 360gpd L.T.A.R. .3

Septic Tank: 1000 Gallons; STB 1012 TP Date 8-27-94

Pump Tank: _____ Gallons; PT _____ Date _____

Pump Make: _____ Model _____ Serial No. _____

Nitrification Field: No Fields 1 Square Feet 1200 Linear Feet 400

No Lines 4 Trench Width 36" Max Trench Bottom Depth 24" Gravel Depth 12"

☑ New System ☐ Repair System Type: I, II, III, IV, V, VI

System Description: gravity conventional

Repair System Description: pumped conventional

Maintenance Agreement Required: ☑ Yes ☐ No

☑ House/Mod. Home ☐ Mobile Home ☐ Business ☐ Other

No. Bedrooms 3 No. Bathrooms 2.5 No. Employees _____


☐ Slab ☐ Crawl Space ☑ Basement w/plumbing ☐ Basement wo/plumbing

Water Supply: ☑ Individual EX ☐ Community ☐ Public


Comments: Keep laterals shallow and on contour.

Comments: Midfield to go in 3 trenches

INITIAL SITE SKETCH

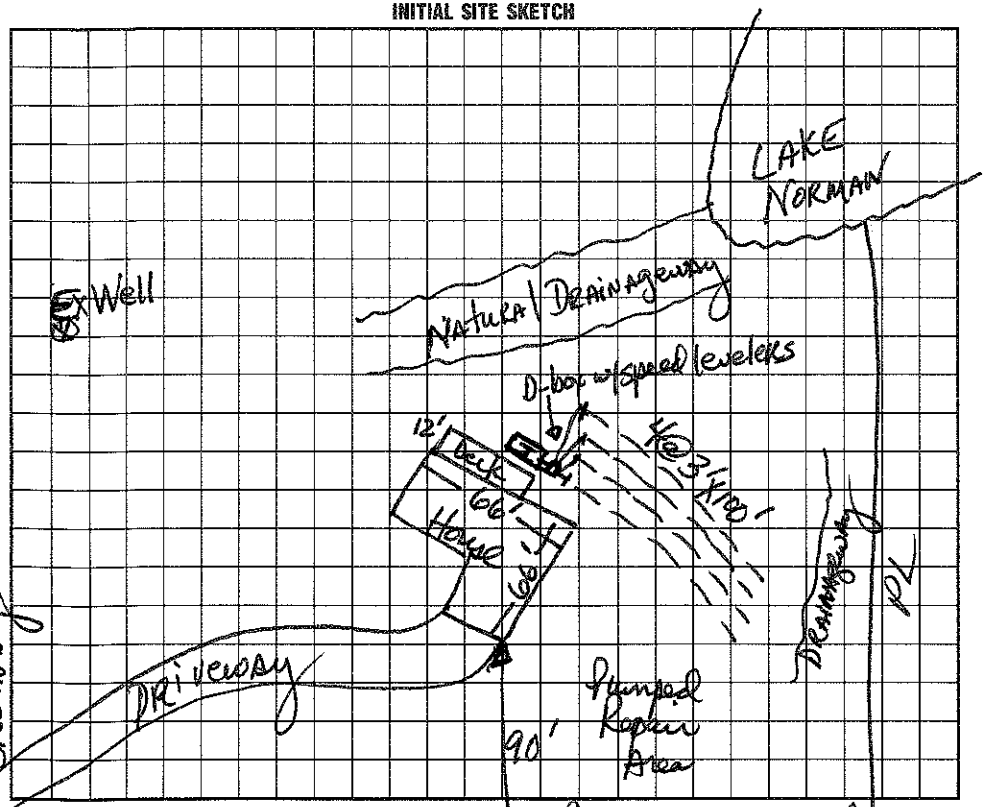

AS BUILT SKETCH

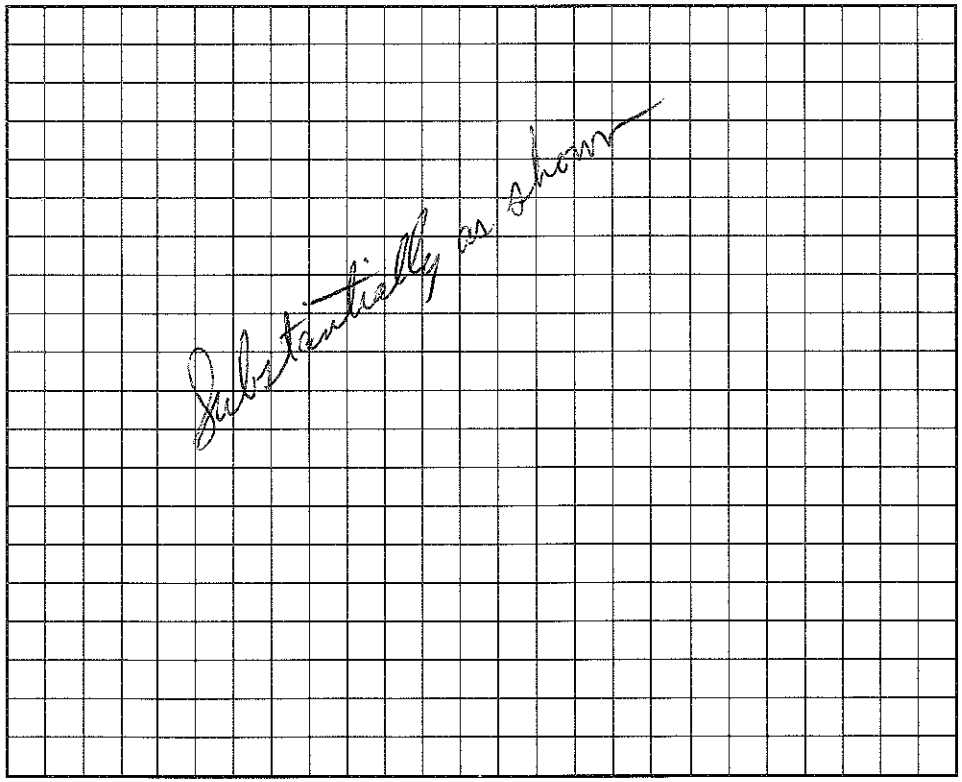

I understand that this permit can be suspended or revoked if any false information is supplied toward securing the permit/any unauthorized changes are made to the site/any unauthorized changes are made in the installation of the system. Improvement Permit is valid for 60 months from date of issuance. PARADISE PENINSULA

Signed: Michael Hepler

Improvement Permit by: Mark R Hanson, RS date Jan 4, 1994

Existing System Inspection by: _____ date _____

Installed by: Tommy Tyre

Certificate of Completion by: D R Hanson, RS date 11/1/94

Operation Permit by: _____ date _____

HEALTH DEPT. COPY: WHITE INSPECTION COPY (FINAL): GREEN OWNER COPY (FINAL): YELLOW INSPECTION COPY (INITIAL): PINK OWNER COPY (INITIAL): GOLD