IREDELL COUNTY HEALTH DEPARTMENT

STATESVILLE 704-878-5305 [redacted] 4627-79-9277 MOORESVILLE

IMPROVEMENT PERMIT / AUTHORIZATION TO CONSTRUCT / OPERATION PERMIT / EXISTING S.

PERMIT# 75622 PIN# 4726889970 PT DATE 6/16/00

OWNER OR CONTRACTOR BRIAN CLODFELTER PHONE: Business _____ Home _____

ADDRESS _____

LOCATION 150W - TL PARADISE PENINSULA - TL BROOKE LN - ON RT

SUBDIVISION PINNACLE SHORES BLOCK / SECTION 4 LOT 13 LOT AREA 1.973AC SITE CLASS. PS DESIGN FLOW 480GPD T.A.R. .25

Septic Tank: 1000 Gallons; STB 825 Date 9/12/00

Pump Tank: 1000 Gallons; PT 30" Date 9/11/00

Pump Make: ZOELLER Model N-139 Serial No. _____

Nitrification Field: No Fields 1 Square Feet 1440 Linear Feet 480

No Lines 5 Trench Width 36" Max Trench Bottom Depth 36" Gravel Depth N/A

☑ New System ☐ Repair System Type: I, II, III, IV, V, VI

System Description: PUMP 25% REDUCTION

Repair System Description: PUMP PANEL

Maintenance Agreement Required: ☐ Yes ☑ No

☑ House/Mod. Home No. Bedrooms 4

☐ Mobile Home No. Bathrooms 4

☐ Business No. Employees _____

☐ Other _____

☐ Slab ☑ Crawl Space ☐ Basement w/plumbing ☐ Basement wo/plumbing

Water Supply: ☐ Individual ☐ Public ☑ Community


Comments:/Conditions:

1" = 50'


Comments:/Conditions: Polydek pipe in S/T.

12/1,100 Aluminum gate

INITIAL SITE SKETCH

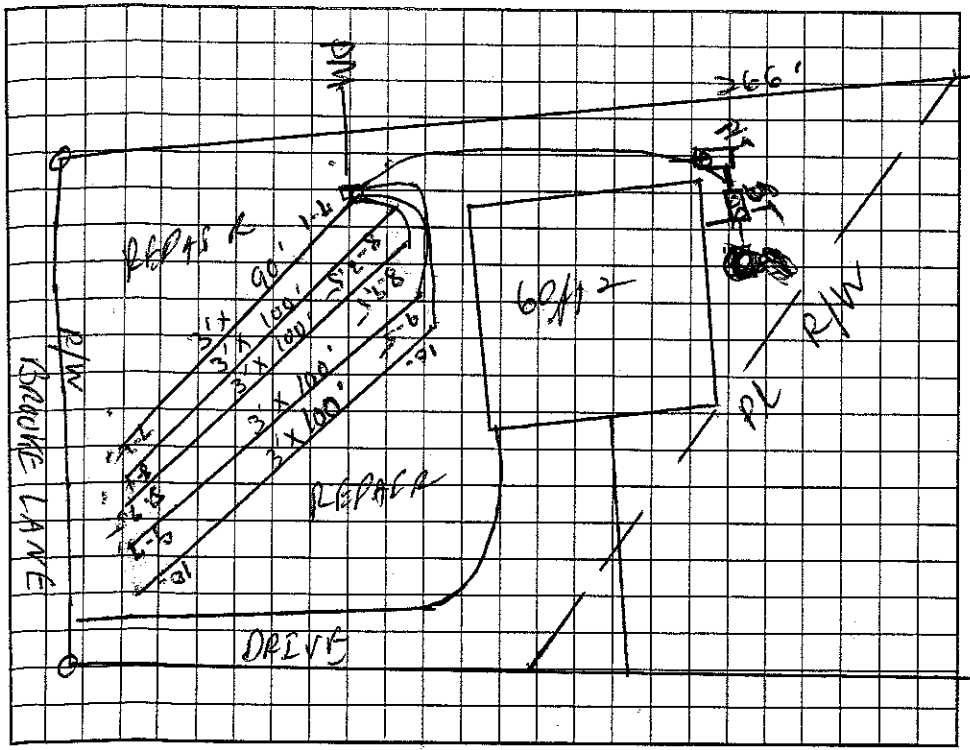

AS BUILT SKETCH

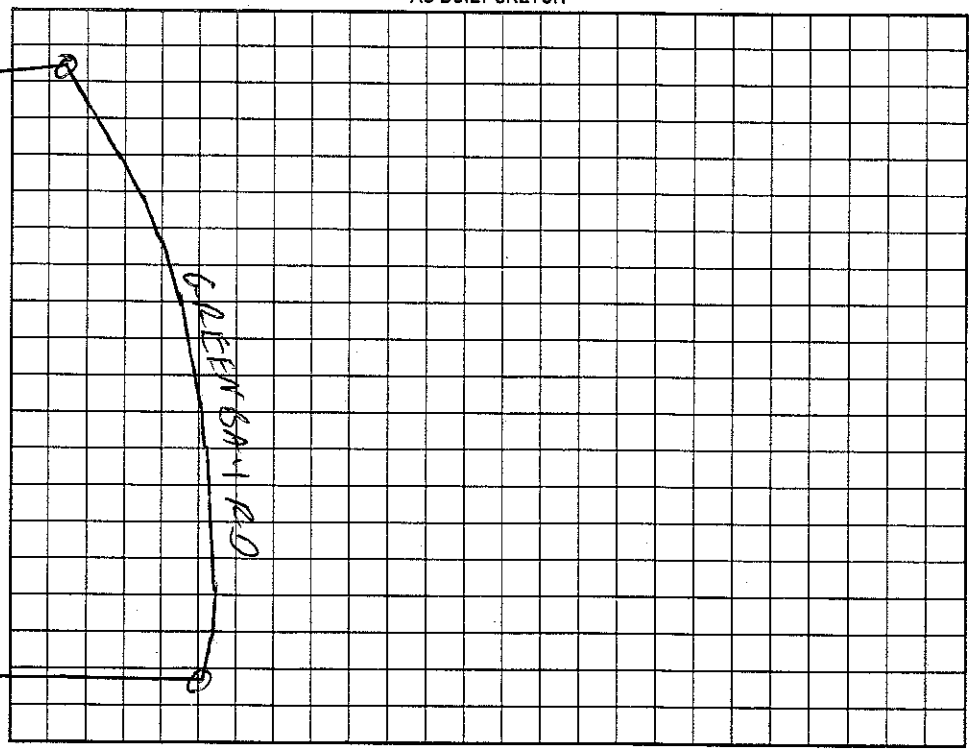

Permit can be suspended or revoked if any false information is supplied toward securing the permit/any unauthorized changes are made to the site/any unauthorized changes are made in the installation of the system. Improvement Permit with plat valid without expiration. Improvement Permit with ~~site plan~~ valid for sixty months. Authorization to Construct is valid for a period equal to that of Improvement Permit – not to exceed sixty months.

Signed: [signature] date _____ Installed by: Wayne Clontz

Improvement Permit by: [signature] RS date 6/16/00 Operation Permit by: Wesley Sparks RS date 2/16/01

Authorization to Construct by: [signature] RS date 6/16/00 Existing System Inspection by: _____ date _____

HEALTH DEPT. COPY: WHITE OWNER COPY (FINAL): YELLOW OWNER COPY (INITIAL): PINK