IREDELL COUNTY HEALTH DEPARTMENT

Statesville Phone TR 3-7271 Mooresville Phone NO 3-1271

PERMIT TO INSTALL SEPTIC TANK

Permit No. _____ Permit Date Dec. 19 [illegible]

Owner T. F. Hallen Address [illegible]

Installed By [illegible] Dishman Address [illegible]


Location of Property Sec 9 Lot 27

Tank		Capacity		Length of Lines		Fixtures	
Block	( )	1000	( )	225'	( )	No. of Baths	( )
Precast	( )	1250	( )	250'	( )	Dishwasher	( )
		1500	( )	Other _____		Garbage Grdr.	( )
		Other _____				Other _____	

NOTIFY HEALTH DEPARTMENT AT LEAST EIGHT HOURS BEFORE TANK IS TO BE INSPECTED.

Final Inspection 18 Dec 19[illegible] Approved (X) Disapproved ( )

Remarks Will not Drain

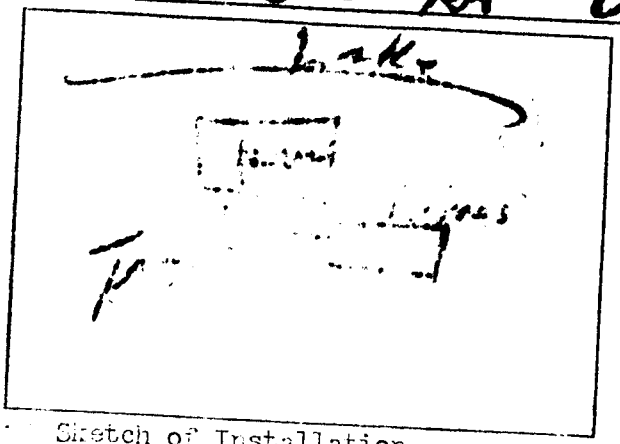

Sketch of Installation

Sanitarian