IREDELL COUNTY HEALTH DEPARTMENT

STATESVILLE 704-878-5305 MOORESVILLE 704-664-5281

IMPROVEMENT PERMIT / AUTHORIZATION TO CONSTRUCT / OPERATION PERMIT / EXISTING SYSTEM INSPECTION

PERMIT# 81034 PIN# 4627819014PT 4627803682 DATE 7-20-2001

OWNER OR CONTRACTOR Mark Faulkenberry PHONE: Business _____ Home 799-6542

ADDRESS 145 Bluewing Ln. Mooresville, NC 28117

LOCATION _____

SUBDIVISION Shavender's Bluff BLOCK / SECTION _____ LOT 64 LOT AREA .72 Acre SITE CLASS. PS DESIGN FLOW 360gpd L.T.A.R. .3

Septic Tank: 1000 Gallons; STB 794 Date 2-14-01
Pump Tank: _____ Gallons; PT _____ Date _____
Pump Make: _____ Model _____ Serial No. _____
Nitrification Field: No Fields 1 Square Feet 1200 Linear Feet 400
No Lines 4@100' Trench Width 36" Max Trench Bottom Depth 36"

X New System ☐ Repair System Type: I (II) III, IV, V, VI
System Description: Gravity-Conventional
Repair System Description: Gravity-Panel
Maintenance Agreement Required: ☒ Yes ☒ No

Gravel Depth 12" ☐ Slab ☒ Crawl Space ☐ Basement w/plumbing ☐ Basement wo/plumbing


X House/Mod. Home No. Bedrooms 3
☐ Mobile Home No. Bathrooms 3
☐ Business No. Employees _____
☐ Other _____

Water Supply: X Individual ☐ Public ☐ Community


Comments:/Conditions:

Comments:/Conditions: Inspected tanks & lines 7/18/200

INITIAL SITE SKETCH Scale 1"=40'

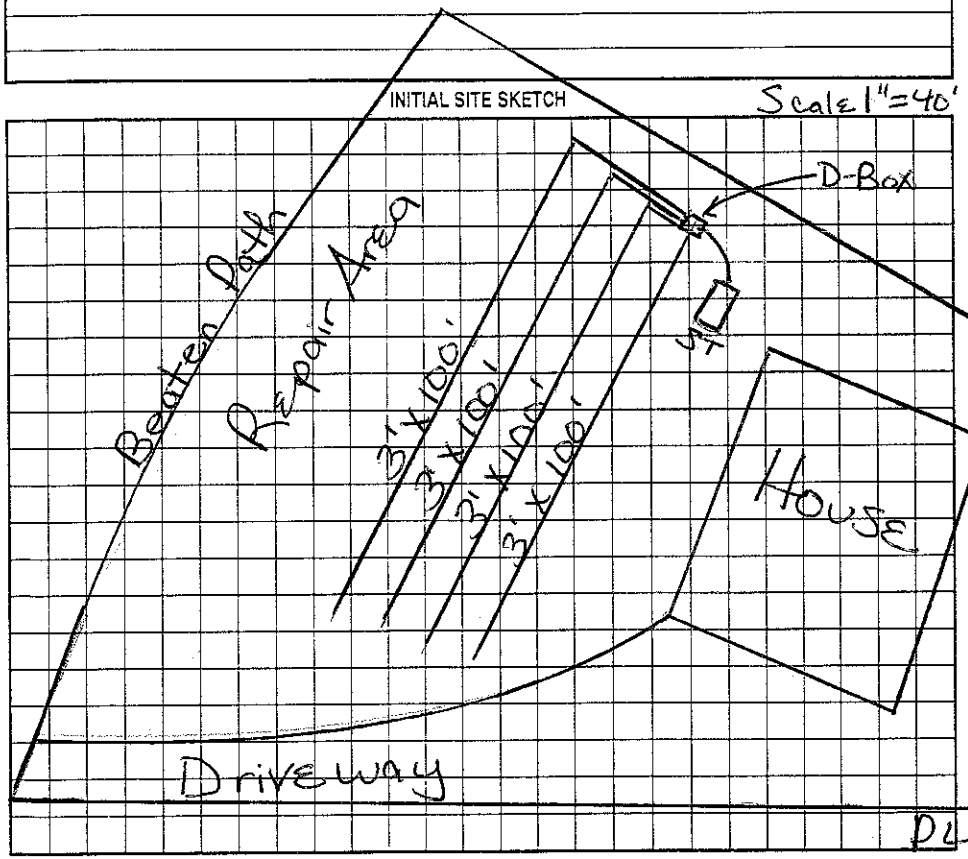

AS BUILT SKETCH

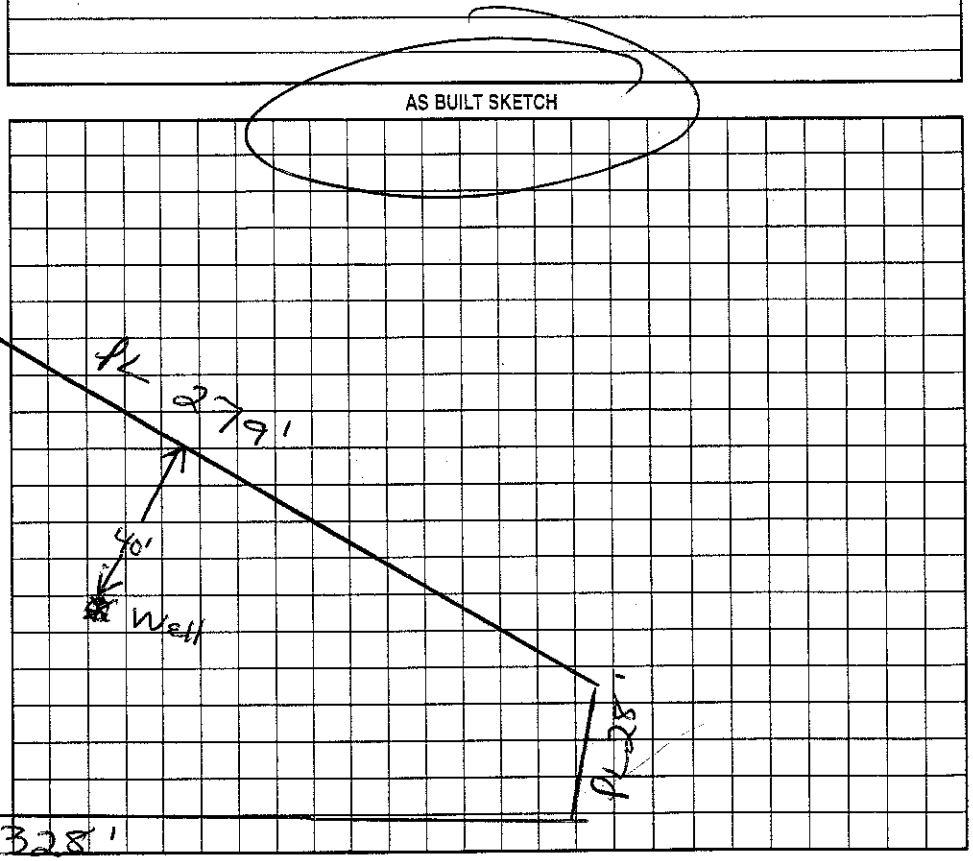

Permit can be suspended or revoked if any false information is supplied toward securing the permit/any unauthorized changes are made to the site/any unauthorized changes are made in the installation of the system. Improvement Permit with plat valid without expiration Improvement Permit with site plan valid for sixty months. Authorization to Construct is valid for a period equal to that of Improvement Permit – not to exceed sixty months.

Signed: _____ date _____ Installed by: Kidd Construction

Improvement Permit by: _____ date _____ Operation Permit by: Maria H. Dotson date 7/20/2001

Authorization to Construct by: Maria H. Dotson date 7/20/2001 Existing System Inspection by: _____ date _____

HEALTH DEPT. COPY: WHITE OWNER COPY (FINAL): YELLOW OWNER COPY (INITIAL): PINK