Don Clemente (704)506 4216 9:30

IREDELL COUNTY HEALTH DEPARTMENT

Statesville Office (704) 878-5305 Mooresville Office (704) 660-3625 PERMIT # 133746

IMPROVEMENT PERMIT / AUTHORIZATION TO CONSTRUCT / OPERATION PERMIT / EXISTING SYSTEM

PIN # 462 7804 199

APPLICANT: Doug Carroll APPLICANT ADDRESS: 1508 Little Falls Dr Concord, NC 28025

SITE ADDRESS: 692 Beaten Path Mooresville NC PHONE: 7046086893 ALT. PHONE:

SITE DIRECTIONS: Brawley School Rd TR Blume TL Beaten Path

SUBDIVISION: CL&T SECTION: 9 LOT # 23 LOT AREA: 1 ac DESIGN FLOW: 480gpd L.T.A.R.: .3

Septic Tank 1000 (gal) STB 794 Date 11/5/14
Pump Tank 1000 (gal) PT 27 Date 10/20/14
Pump Make Goulds Model WE0511H Serial #
Nitrification Fields 1 # Lines 6 Linear Ft: 400
Trench Width 36" Max. Trench Bottom Depth 36" Gravel Depth N/A

☒ New System ☐ Repair ☐ Expansion System Type: I II ☒ III IV V VI
System Description: Pump - Pm - 25% Reduction
Repair System Description: 1 & PPBPS
Maintenance Agreement Required: ☐ YES ☒ NO ☐ GRAVITY ☒ PRESSURE

☒ Residence ☐ Business ☐ Other ☐ Slab ☒ Basement w/plumbing
No. Bedrooms 4 No. Persons 8 No. Employees ☐ Crawl Space ☐ Basement w/o plumbing

Water Supply: ☒ Private ☐ Public ☐ Community

Comments / Conditions:

Note: This permit replaces previous permit dated 8/11/14. S/T & P/T Location was Changed

INITIAL SITE SKETCH

See approved attached plan by Michael Athanas & Assoc. (approved 8/29/14)

2' Pressure Head Set 5/6/15 SC

AS BUILT SKETCH

- Checked 12/9/14 First 3 Lines (B7, W8, 09) OK SC
- Checked 12/15/14 Remaining Drainfield OK SC
- Tanks and Supply Line OK 12/19/14 SC
- Floats OK

GOULDS WATER TECHNOLOGY

WE0511H
SUBMERSIBLE PUMP
1/2HP 1/60/115 3.56" 14.5MA

PENDING

Permit can be suspended or revoked if any false information is supplied toward securing the permit / any unauthorized changes are made to the site / any unauthorized changes are made in the installation of the system. **CONTACT A LOCATOR SERVICE PRIOR TO ANY EXCAVATION**

☐ **IMPROVEMENT PERMIT** *with plat valid without expiration.* ☒ **IMPROVEMENT PERMIT** *with site plan valid for 60 mos.* ☒ **AUTHORIZATION TO CONSTRUCT** *valid for period equal to IMPROVEMENT PERMIT--not to exceed 60 mo.*

Owner / Applicant Signature: Date: 12-9-14 Installed by: Adam Clemente

IMPROVEMENT PERMIT by: RS Date: 8/29/14 OPERATION PERMIT by: Date: 5/22/15

AUTHORIZATION TO CONSTRUCT by: RS Date: 8/29/14 Existing System Inspected by: Date:

Health Dept. Copy - WHITE Applicant (Final Approval) - YELLOW Applicant (Conditional Approval) - PINK

SURVEYING – PLANNING – MAPPING
P.O. BOX 2727 (704) 399-9120
HUNTERSVILLE, NC 28070 FAX (704) 398-1226
© PINNACLE LAND SURVEYING, PA


A

KLAUS E. KRUEGER PLS L-3808

8/29/14

Note: Old ST was abandoned greater than 30 days ago.

LAKE NORMAN

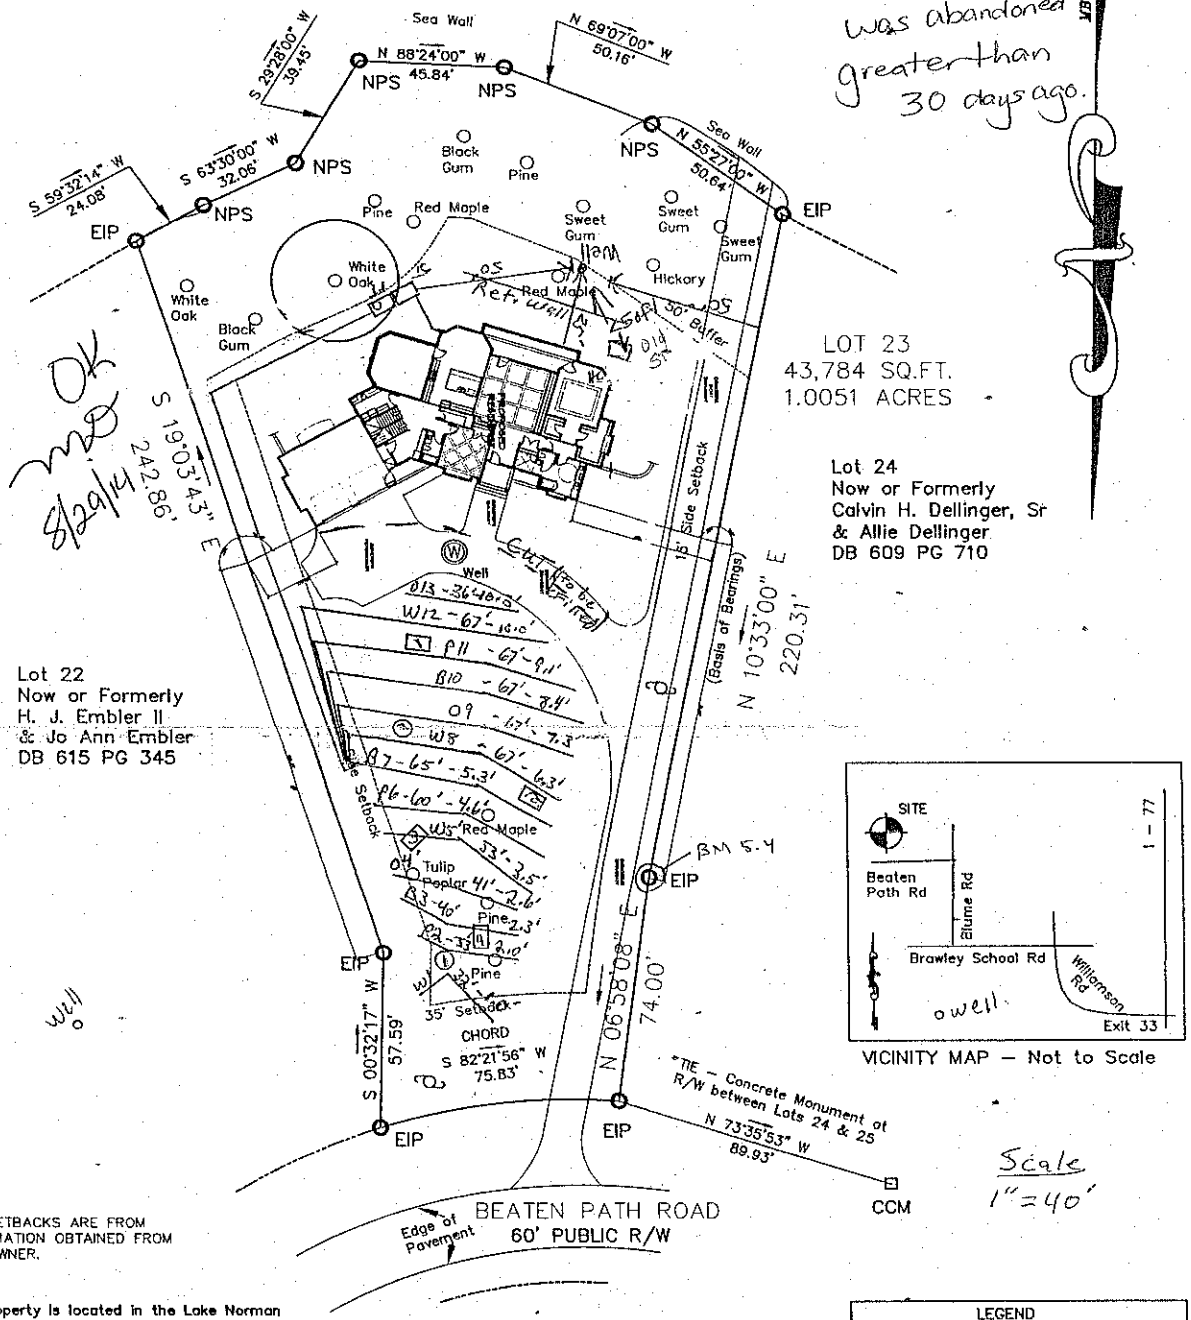

OK mb 8/29/14

Scale 1"=40'

VICINITY MAP – Not to Scale

NOTE:
THE SETBACKS ARE FROM INFORMATION OBTAINED FROM THE OWNER.

LEGEND			
SETBACK			
EASEMENT			
PROPERTY LINE			
LINES NOT SURVEYED			
FEATURE			
RIGHT OF WAY			
SET IRON PIN	O SIP		
EXISTING IRON PIN	O EIP		
CONCRETE MONUMENT	⊡ CCM		
NO PIN SET	O NPS	WATER METER	
POWER POLE		CATCH BASIN	
SEWER MANHOLE	Ⓢ	LAMP POST	
UTILITY BOX		ELECTRIC BOX	

This property is located in the Lake Norman Watershed Area.
There are several restrictions associated with this area which may apply to this property.

I certify that this survey was performed by me (Klaus E. Krueger), under my supervision.
This survey is of an existing parcel of land.
The Raw Error of Closure was better than 1:10,000.
I did not do a full title search on this property.

This House is not located within any Special flood hazard area as shown on Firm Maps of this area (Panel 370313 0200 B) dated May 15, 1980

DATE of:
Survey 10/18/05
Drawing 10/18/05
Job No: 4294
File: 692BEATENPATH2
Drawn by: KEK

For Owner:
DOUGLAS CARROLL
Physical Survey of
692 BEATEN PATH ROAD
MOORESVILLE, NORTH CAROLINA 28117
DAVIDSON TOWNSHIP, IREDELL COUNTY

Map Recorded in Map Book 14 Page 93
Lot 23 Section 9, Crescent Land & Timber Corp.

Deed Recorded in Deed Book 1545 Page 2354
Tax Parcel # 000077407006